

Notice: Fill out COMPLETELY and return to Conservation Division at the address below within 60 days from plugging date

KANSAS CORPORATION COMMISSION OIL & GAS CONSERVATION DIVISION

Form CP-4 December 2003 Type or Print on this Form Form must be Signed All blanks must be Filled

WELL PLUGGING RECORD

K.A.R. 82-3-117

Lease Operator: Presco Western, LLC

Address: 5665 FLATIRON PARKWAY BOULDER CO 80301

Phone: 303-305-1163 Operator License #: 32309

Type of Well: Oil Docket #: (Oil, Gas D&A, SWD, ENHR, Water Supply Well, Cathodic, Other) (If SWD or ENHR)

The plugging proposal was approved on: 10/2/2008 (Date)

by: Steve Durant (KCC District Agent's Name)

Is ACO-1 filed? [X] Yes [ ] No If not, is well log attached? [ ] Yes [ ] No

Producing Formation(s): List All (If needed attach another sheet)

Depth to Top: Bottom: T.D.

Depth to Top: Bottom: T.D.

Depth to Top: Bottom: T.D.

API Number: 15- 187-20840-0000

Lease Name: Dwight Leroy

Well Number: 1-35

Spot Location (QQQQ): - - NW - SW

1,980 Feet from [ ] North / [X] South Section Line

660 Feet from [ ] East / [X] West Section Line

Sec. 35 Twp. 29 S. R. 40 [ ] East [X] West

County: Stanton

Date Well Completed: 10/1/2008

Plugging Commenced: 10/2/2008

Plugging Completed: 5/19/2009

Show depth and thickness of all water, oil and gas formations.

Table with columns: Oil, Gas or Water Records (Formation, Content) and Casing Record (Surface Conductor & Production) (From, To, Size, Put in, Pulled out)

Describe in detail the manner in which the well was plugged, indicating where the mud fluid was placed and the method or methods used in introducing it into the hole.

1st Plug: CIBP @ 5,550' w/ 2 SX cmt. 2nd Plug: 50 SX cmt @ 1,743'. 3rd Plug: 50 SX cmt from 700' to surface, dumped 5 SX cmt to top off plug. 4th Plug: 1 BBL cmt pumped down surface csg.

\* all cement used is 100/40 Poz.

Name of Plugging Contractor: Basic Energy Services LP License #: 34069

Address: PO Box 10460, Midland, TX 79702

Name of Party Responsible for Plugging Fees: Presco Western, LLC

State of Colorado County, Boulder, ss.


Keli Kowalski (Employee of Operator) or (Operator) on above-described well, being first duly sworn on oath, says: That I have knowledge of the facts statements, and matters herein contained, and the log of the above-described well as filed and the same are true and correct, so help me God.

(Signature) Keli Kowalski

(Address) 5665 Flatiron Parkway, Boulder, CO 80301

SUBSCRIBED and SWORN TO before me this 27th day of May, 2009


(Signature) Kathleen F. Denzer My Commission Expires: 2-12-2011 Notary Public

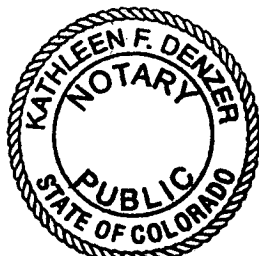

PRT

DWIGHT LEROY 1-35  
15-187-20840

PLUGGING COMMENCED:  
10/3/08  
PLUGGING COMPLETED  
5/19/09  
COMPANY REP:  
STEVE RIDENOUR/CLINT ANDREWS  
PLUGGING APPROVED:  
VERBALLY ON 10/2/08  
BY STEVE DURANT (KCC)  
PLUGGING CONTRACTOR:  
BASIC ENERGY

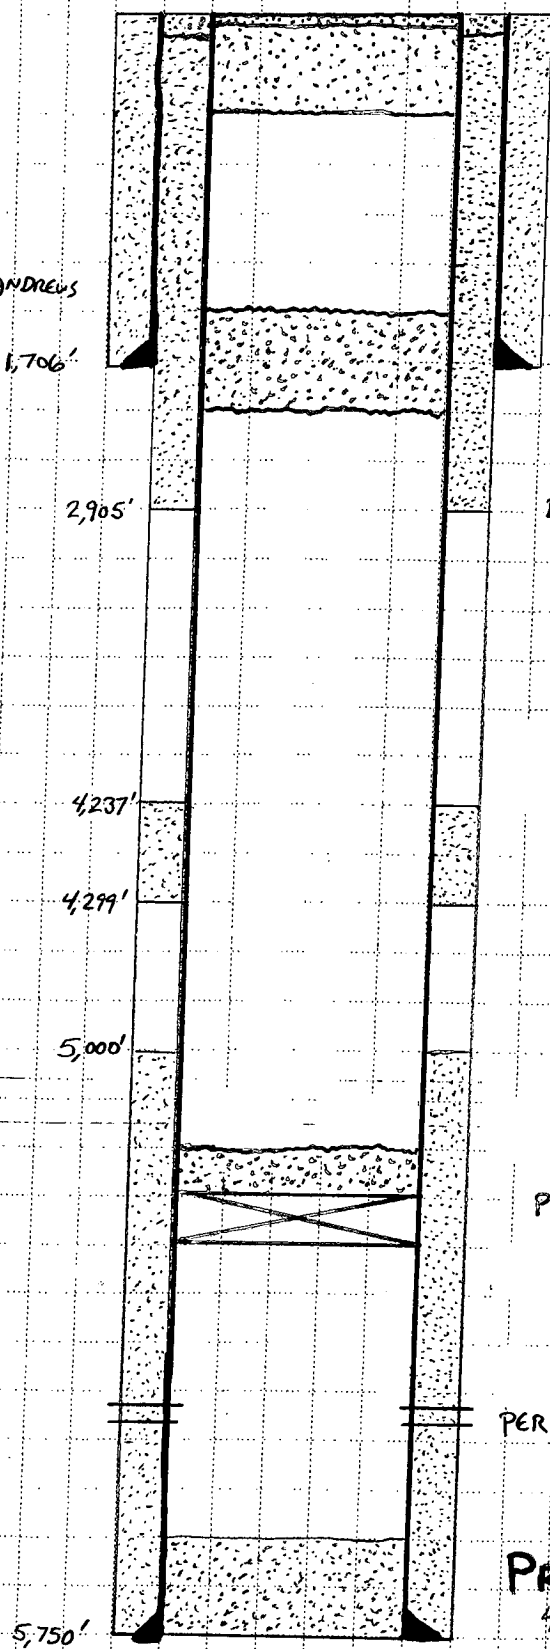

PLUG #4 1 BBL CMT PUMPED DOWN  
SURFACE CASING

PLUG #3 50 SXS 60/40 POZ CMT FROM 700'  
TO SURFACE, DUMPED 5 SXS 60/40  
POZ CMT TO TOP OFF PLUG

PLUG #2 50 SXS 60/40 POZ CMT @ 1,743'

**SURFACE CSG**

8 5/8" 28# H-40 @ 1,706'  
CMT'D W/ 650 SXS CMT

DV TOOL @ 2,905'  
CMT'D TO SURFACE W/ 600 SXS

RECEIVED

MAY 28 2009

KCC WICHITA

PLUG #1 CIBP @ 5,550' W/ 2 SXS CMT ON TOP

PERFS 5,612' - 5,620' (ST. LOUIS)

**PRODUCTION CSG**

4 1/2" 10.5# K-55 @ 5,749'  
CMT'D W/ 250 SXS CMT