


STATE OF KANSAS  
STATE CORPORATION COMMISSION

Give All Information Completely  
Make Required Affidavit  
Mail or Deliver Report to:  
Conservation Division  
State Corporation Commission  
P. O. Box 17027  
Wichita, Kansas 67217  
NORTH

WELL PLUGGING RECORD

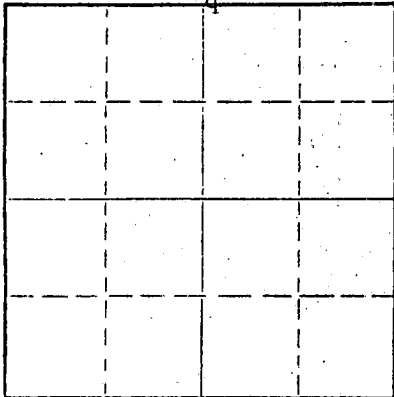

Locate well correctly on above  
Section Plat

Logan County, Sec. 35 Twp. 11 Rge. 33W (E) (W)  
Location as "NE/CNW/SE/SW" or footage from lines C SW SW  
Lease Owner Donald C. Slawson  
Lease Name Herdt 'B' Well No. 1  
Office Address 408 One Twenty Building  
Character of Well (completed as Oil, Gas or Dry Hole) dry hole  
Date well completed June 29 19 77  
Application for plugging filed June 29 19 77  
Application for plugging approved June 29 19 77  
Plugging commenced June 29 19 77  
Plugging completed June 29 19 77  
Reason for abandonment of well or producing formation temp. abandoned

If a producing well is abandoned, date of last production 19  
Was permission obtained from the Conservation Division or its agents before plugging was commenced? yes

Name of Conservation Agent who supervised plugging of this well Gilbert Balthazor  
Producing formation \_\_\_\_\_ Depth to top \_\_\_\_\_ Bottom \_\_\_\_\_ Total Depth of Well 4740 Feet  
Show depth and thickness of all water, oil and gas formations.

OIL, GAS OR WATER RECORDS

CASING RECORD

FORMATION	CONTENT	FROM	TO	SIZE	PUT IN	PULLED OUT
				8 5/8"	520'	

Describe in detail the manner in which the well was plugged, indicating where the mud fluid was placed and the method or methods used in introducing it into the hole. If cement or other plugs were used, state the character of same and depth placed, from \_\_\_\_\_ feet to \_\_\_\_\_ feet for each plug set.

1st plug @ 1400' w/70 sx  
2nd plug @ 550' w/20 sx

RECEIVED  
STATE CORPORATION COMMISSION  
7-21-1977  
JUL 21 1977  
CONSERVATION DIVISION  
Wichita, Kansas

(If additional description is necessary, use BACK of this sheet)  
Name of Plugging Contractor Slawson Drilling Company, Inc.  
Address 408 One Twenty Building, Wichita, Kansas

STATE OF Kansas, COUNTY OF Sedgwick, ss.  
R.J. Thatcher (employee of owner) or (owner or operator) of the above-described well, being first duly sworn on oath, says: That I have knowledge of the facts, statements, and matters herein contained and the log of the above-described well as filed and that the same are true and correct. So help me God.

(Signature) R.J. Thatcher  
R.J. Thatcher, 408 120 Building, Wichita, KS  
(Address)

SUBSCRIBED AND SWORN TO before me this 15 day of July, 19 77.

My commission expires 11-9-80

MarGene Hamer

Notary Public.



WELL LOG

OPERATOR: Donald C. Slawson  
 408 One Twenty Building  
 Wichita, Kansas 67202

LEASE: #1 Herdt 'B'  
 C SW SW Sec. 35-11-33W  
 Logan County, Kansas

CONTRACTOR: Slawson Drilling Company, Inc.

COMMENCED: June 20, 1977

COMPLETED: June 29, 1977

CASING: Surface - 8 5/8" @ 520' w/300 sx 60/40 poz

0 - 524	Surface hole
524 - 1597	Shale and shells
1597 - 2235	Shale, shells and sand
2235 - 2312	Shale and lime
2312 - 2570	Shale and shells
2570 - 2574	Shale
2574 - 2600	Anhydrite
2600 - 4020	Shale and lime
4020 - 4115	Lime
4115 - 4197	Lime and shale
4197 - 4254	Lime
4254 - 4319	Lime and shale
4319 - 4470	Lime
4470 - 4740	Lime and shale
4740	RTD

STATE OF KANSAS )  
 ) SS.  
 COUNTY OF SEDGWICK )

I, R.J. Thatcher, of the Slawson Drilling Company, Inc. upon oath state that the above and foregoing is a true and correct copy of the log of the #1 Herdt 'B' well.

*R.J. Thatcher*  
 \_\_\_\_\_  
 R.J. Thatcher

Subscribed and sworn to before me this 15th day of July, 1977.

*Margene Hamer*  
 \_\_\_\_\_  
 MarGene Hamer, Notary Public

My Commission Expires: 11/9/80

