


STATE OF KANSAS  
STATE CORPORATION COMMISSION

WELL PLUGGING RECORD

Give All Information Completely  
Make Required Affidavit  
Mail or Deliver Report to  
Conservation Division  
State Corporation Comm.  
245 North Water  
Wichita, KS 67202

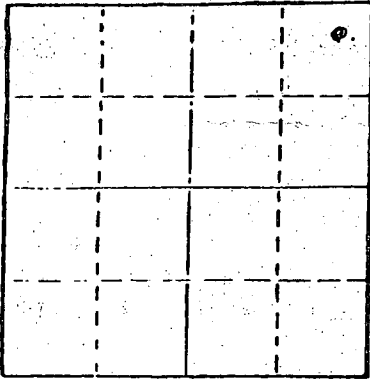

Locate well correctly on above  
Section Plat

Location as Logan County. Sec. 35 Twp. 11S Rge. 33WE/W  
"NE/CNW $\frac{1}{4}$ SW $\frac{1}{4}$ " or footage from lines NE/NE/NE

Lease Owner Lavern Becker Oil  
Lease Name Heard Well No. #1  
Office Address Route 2, Russell, Ka.  
Character of Well (Completed as Oil, Gas or Dry Hole) Dry Hole

Date Well completed 4-25-82 19  
Application for plugging filed 4-25-82 19  
Application for plugging approved 4-25-82 19  
Plugging commenced 4-25-82 19  
Plugging completed 4-25-82 19

Reason for abandonment of well or producing formation Dry Hole  
If a producing well is abandoned, date of last production 19

Was permission obtained from the Conservation Division or its agents before plugging was commenced? Yes

Name of Conservation Agent who supervised plugging of this well Carl Goodrow  
Producing formation None Depth to top          Bottom          Total Depth of Well 4720  
Show depth and thickness of all water, oil and gas formations.

OIL, GAS OR WATER RECORDS

CASING RECORD

FORMATION	CONTENT	FROM	TO	SIZE	PUT IN	PULLED OUT

Describe in detail the manner in which the well was plugged, indicating where the mud fluid was placed and the method or methods used in introducing it into the hold. If cement or other plugs were used, state the character of same and depth placed, from          feet to          feet for each plug set.

1st plug 1500' with 100 SKA.  
2nd plug 400' " 40 SKA.  
3 solid plugs at 40' 8 $\frac{5}{8}$  with 10 SKA.  
10 SKA in Rat hole.  
total of 160 SKA cement 50-50 poz 4% gel. 1% CC.

(If additional description is necessary, use BACK of this sheet)

Name of Plugging Contractor Sun oilwell Cementing.

STATE OF Kansas COUNTY OF Russell, ss.  
Lavern Becker Oil (employee of owner) or (owner or operator)  
of the above-described well, being first duly sworn on oath, says: That I have knowledge of the facts, statements, and matters herein contained and the log of the above-described well as filed and that the same are true and correct. So help me God.

(Signature) Lavern Becker

(Address)

SUBSCRIBED AND SWORN TO before me this 4th day of May, 19 82

My **RECEIVED** STATE CORPORATION COMMISSION March 9, 1984

Leo J. Vap Notary Public.

**MAY - 6 1982**  
**5-6-1982**  
**CONSERVATION DIVISION**  
**Wichita, Kansas**

**LEO J. VAP**  
Rush County, Ks.  
My Appt. Exp.