


STATE OF KANSAS  
STATE CORPORATION COMMISSION

Give All Information Completely  
Make Required Affidavit  
Mail or Deliver Report to:  
Conservation Division  
State Corporation Commission  
212 North Market, Insurance Bldg.  
Wichita, Kansas

15-109-00043-00-00  
WELL PLUGGING RECORD

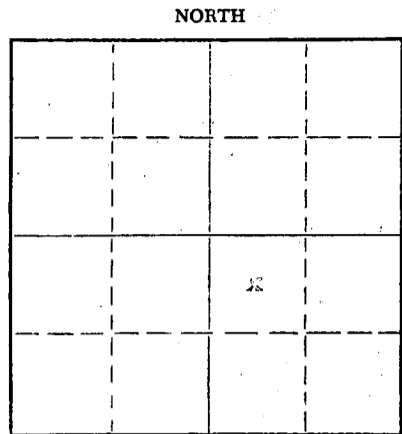

Locate well correctly on above Section Plat

Logan County, Sec. 9 Twp. 11S Rge. 34 (E) (W)  
Location as "NE/CNW/SW" or footage from lines C NW 1/4 SW 1/4  
Lease Owner Target Drilling Corporation  
Lease Name Betrand Well No. 1  
Office Address 910 Enterprise Bldg. Tulsa, Oklahoma  
Character of Well (completed as Oil, Gas or Dry Hole) 10-1 Dry Hole  
Date well completed 10-1 19 61  
Application for plugging filed 10-1 19 61  
Application for plugging approved 10-1 19 61  
Plugging commenced 10-1 19 61  
Plugging completed 10-1 19 61  
Reason for abandonment of well or producing formation No productive horizons encountered

If a producing well is abandoned, date of last production 19  
Was permission obtained from the Conservation Division or its agents before plugging was commenced? yes

Name of Conservation Agent who supervised plugging of this well Eldon Petty  
Producing formation None Depth to top x Bottom x Total Depth of Well 405 Feet  
Show depth and thickness of all water, oil and gas formations.

OIL, GAS OR WATER RECORDS

CASING RECORD

FORMATION	CONTENT	FROM	TO	SIZE	PUT IN	PULLED OUT
Water Sand	Fresh Water	15'	60'	8 5/8"	180'	None

Describe in detail the manner in which the well was plugged, indicating where the mud fluid was placed and the method or methods used in introducing it into the hole. If cement or other plugs were used, state the character of same and depth placed, from feet to feet for each plug set.

Set cement plug at 550' with twenty sacks cement, filled hole with mud to 180' and set cement plug with twenty sacks cement, filled hole with mud to 40' from surface, and set plug with ten sacks cement, with two wires attached to plug and extending to surface.

RECEIVED  
STATE CORPORATION COMMISSION  
10-16-1961  
OCT 16 1961  
CONSERVATION DIVISION  
Wichita, Kansas

Name of Plugging Contractor Halliburton Company (If additional description is necessary, use BACK of this sheet)  
Address Hays, Kansas

STATE OF Oklahoma, COUNTY OF Tulsa, ss.  
J. W. Garner (employee of owner) or (owner or operator) of the above-described well, being first duly sworn on oath, says: That I have knowledge of the facts, statements, and matters herein contained and the log of the above-described well as filed and that the same are true and correct. So help me God.

(Signature) J. W. Garner  
910 Enterprise Building (Address)

SUBSCRIBED AND SWORN TO before me this 6th day of October, 19 61

March 24, 1965

My commission expires

Betty J. Cunningham  
Notary Public.



15-109-00043-00-00

TARGET DRILLING CORPORATION

910 ENTERPRISE BUILDING  
TULSA 3, OKLAHOMA

Well No 1  
6 NW/4 SW/4  
Section 9-118-24W  
Logan County Kansas

DRILLERS SAMPLE DESCRIPTION

0-1020'  
1020-1360  
1360-1620  
1620-2020  
2020-2471  
2471-2809  
2809-3397  
3397-3460  
3460-3512  
3512-4000

Shale and Chalk  
Shale and Sand  
Sand and Lime  
Shale and Chalk  
Red Bed, Shale and Lime  
Red Bed and Lime  
Lime and Shale  
Red Bed and Lime  
Lime and Shale  
Lime

RECEIVED  
STATE CORPORATION COMMISSION  
OCT 16 1961  
CONSERVATION DIVISION  
Wichita, Kansas

*J. W. Ganser*  
J. W. Ganser

State of Oklahoma )  
County of Tulsa )

Subscribed and sworn to me a Notary Public this 6th of October 1961.

*Betty J. Livingston*  
Notary Public

My Commission expires March 24, 1965

