


Give All Information Completely
Make Required Affidavit
Mail or Deliver Report to:
Conservation Division
State Corporation Commission
P. O. Box 17027
Wichita, Kansas 67217
NORTH

15-09-20219-00-00

WELL PLUGGING RECORD

Logan County, Sec. 24 Twp. 11S Rge. (E) 34W (W)

Location as "NE/CNW/SW" or footage from lines SE NE NE
Lease Owner Donald C. Slawson
Lease Name Wassemiller 'C' Well No. 1
Office Address 200 Douglas Building
Character of Well (completed as Oil, Gas or Dry Hole) Dry Hole
Date well completed February 3, 1982
Application for plugging filed February 3, 1982
Application for plugging approved February 3, 1982
Plugging commenced February 3, 1982
Plugging completed February 3, 1982
Reason for abandonment of well or producing formation Dry Hole

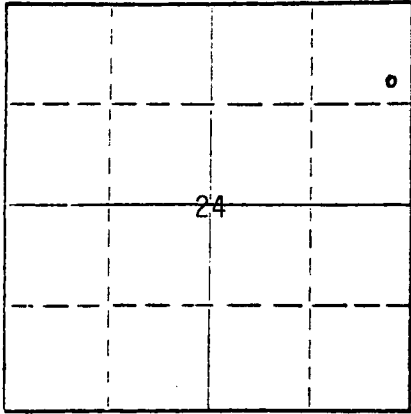

Locate well correctly on above Section Plat

If a producing well is abandoned, date of last production 19
Was permission obtained from the Conservation Division or its agents before plugging was commenced? Yes

Name of Conservation Agent who supervised plugging of this well Carl Goodrow Box 189, Penokee, KS 67659
Producing formation Depth to top Bottom Total Depth of Well 4400 Feet
Show depth and thickness of all water, oil and gas formations.

OIL, GAS OR WATER RECORDS

CASING RECORD

FORMATION	CONTENT	FROM	TO	SIZE	PUT IN	PULLED OUT
		surface	567'	8 5/8"		

Describe in detail the manner in which the well was plugged, indicating where the mud fluid was placed and the method or methods used in introducing it into the hole. If cement or other plugs were used, state the character of same and depth placed, from feet to feet for each plug set.

1st plug @ 1560' w/70 sx
2nd plug @ 540' w/40 sx
3rd plug @ 40' w/10 sx
10 sx in Rat Hole


RECEIVED
STATE CORPORATION COMMISSION

MAR 10 1982
3-10-1982
CONSERVATION DIVISION
Wichita, Kansas

Name of Plugging Contractor Sun Oil Well Cementing, Inc.
Address Box 169 Great Bend, Kansas 67530

STATE OF KANSAS COUNTY OF SEDGWICK ss.

William R. Horigan (employee of owner) or (owner or operator) of the above-described well, being first duly sworn on oath, says: That I have knowledge of the facts, statements, and matters herein contained and the log of the above-described well as filed and that the same are true and correct. So help me God.

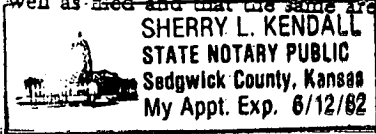

(Signature) William R. Horigan

200 Douglas Bldg. (Address) Wichita, Kansas 67202
March 19 82

Subscribed and Sworn to before me this 2nd day of March, 19 82

Sherry L. Kendall
Sherry L. Kendall Notary Public.

My commission expires 06/12/82