

15-109-20034-00-00

FORM CP-4

STATE OF KANSAS
STATE CORPORATION COMMISSION
CONSERVATION DIVISION
P. O. BOX 17027
WICHITA, KANSAS 67217

WELL PLUGGING RECORD

Logan County, Sec. 36 Twp. 11S Rge. (E) 34 (W)

Location as "NE/CNWxSWx" or footage from lines C SE NW

Lease Owner Abercrombie Drilling, Inc.

Lease Name COLGLAZIER Well No. 1

Office Address 801 Union Center, Wichita, Kansas 67202

Character of Well (completed as Oil, Gas or Dry Hole) Dry Hole

Date well completed April 7 1975

Application for plugging filed (verbally) April 7 1975

Application for plugging approved (verbally) April 7 1975


Plugging commenced April 7 1975

Plugging completed April 7 1975

Reason for abandonment of well or producing formation No commercial quantities of oil or gas encountered.

If a producing well is abandoned, date of last production 19

Was permission obtained from the Conservation Division or its agents before plugging was commenced? Yes (verbally)

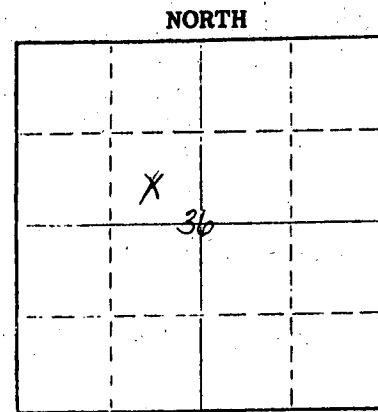

Locate well correctly on above Section Plat

Name of Conservation Agent who supervised plugging of this well Gilbert Balthazor

Producing formation _____ Depth to top _____ Bottom _____ Total Depth of Well 4790 Feet

Show depth and thickness of all water, oil and gas formations.

OIL, GAS OR WATER RECORDS

CASING RECORD

FORMATION	CONTENT	FROM	TO	SIZE	PUT IN	PULLED OUT
				8-5/8"	270'	None

Describe in detail the manner in which the well was plugged, indicating where the mud fluid was placed and the method or methods used in introducing it into the hole. If cement or other plugs were used, state the character of same and depth placed, from _____ feet to _____ feet for each plug set.

1st Plug Set @ 1500' with 70 sx. 50/50 Posmix 6% gel

2nd Plug Set @ 270' with 20 sx.

3rd Plug Set @ 40' with 10 sx.

RECEIVED
STATE CORPORATION COMMISSION
APR 17 1975
CONSERVATION DIVISION
Wichita, Kansas

(If additional description is necessary, use BACK of this sheet)

Name of Plugging Contractor Abercrombie Drilling, Inc.

Address 801 Union Center, Wichita, Ks. 67202

STATE OF KANSAS COUNTY OF SEDGWICK, ss.

Jerry A. Langrehr, Exec. Vice Pres. (employee of owner) or (owner or operator) of the above-described well, being first duly sworn on oath, says: That I have knowledge of the facts, statements, and matters herein contained and the log of the above-described well as filed and that the same are true and correct. So help me God.

(Signature) Jerry A. Langrehr

801 Union Center, Wichita, Kansas 67202

(Address)

16th day of April 1975

Nancy E. Haner
Nancy E. Haner
Notary Public.

