

15-109-20156-00-00


STATE OF KANSAS
STATE CORPORATION COMMISSION

WELL PLUGGING RECORD

Give All Information Completely
Make Required Affidavit
Mail or Deliver Report to
Conservation Division
State Corporation Comm.
245 North Water
Wichita, KS 67202

Logan County, Sec. 35 Twp. 11S Rge. 34 E/W
Location as "NE/CNW $\frac{1}{4}$ SW $\frac{1}{4}$ " or footage from lines
150' NW of C NE NW

Lease Owner Abercrombie Drilling, Inc.
Lease Name SCHEETZ Well No. 1
Office Address 801 Union Center, Wichita, Kansas
Character of Well (Completed as Oil, Gas or Dry Hole)
Dry Hole

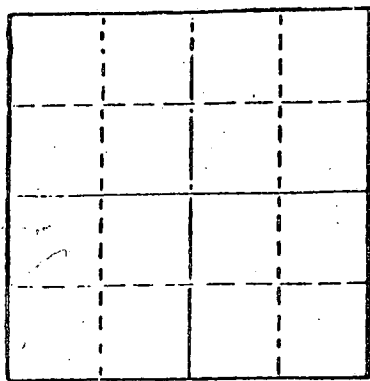

Locate well correctly on above
Section Plat

Date Well completed 11-03-1980
Application for plugging filed 11-03-1980
Application for plugging approved 11-03-1980
Plugging commenced 11-03-1980
Plugging completed 11-03-1980

Reason for abandonment of well or producing formation
No commercial quantity of oil or gas available
If a producing well is abandoned, date of last production
19

Was permission obtained from the Conservation Division or
its agents before plugging was commenced? Yes

Name of Conservation Agent who supervised plugging of this well Gilbert Balthazar
Producing formation _____ Depth to top _____ Bottom _____ Total Depth of Well 4855'
Show depth and thickness of all water, oil and gas formations.

OIL, GAS OR WATER RECORDS

CASING RECORD


FORMATION	CONTENT	FROM	TO	SIZE	PUT IN	PULLED OUT

Describe in detail the manner in which the well was plugged, indicating where the mud fluid was placed and the method or methods used in introducing it into the hold. If cement or other plugs were used, state the character of same and depth placed, from _____ feet to _____ feet for each plug set.

T.D. 4855'

Set 1st plug @ 1450' with 70 sx.
2nd plug @ 260' with 20 sx.
3rd plug @ 40' solid bridge with 10 sx.
Rathole with 5 sx.

Plug was down @ 9:00 a.m. 11-03-80

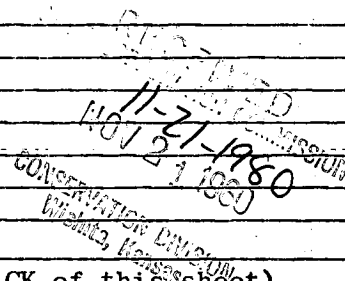

(If additional description is necessary, use BACK of this sheet)

Name of Plugging Contractor Abercrombie Drilling, Inc.

STATE OF Kansas COUNTY OF Sedgwick, ss.
Jack L. Partridge, Asst. Sec.-Treas. (employee of owner) or (owner or operator)
of the above-described well, being first duly sworn on oath, says: That I have knowledge of the facts, statements, and matters herein contained and the log of the above-described well as filed and that the same are true and correct. So help me God.

(Signature) Jack L. Partridge
801 Union Center, Wichita, Kansas
(Address)

SUBSCRIBED AND SWORN TO before me this 18th day of November, 1980

Jeanette A. Metheny
Jeanette A. Metheny Notary Public.

My commission expires 08-18-84

