


15-109-00003-00-00

WELL PLUGGING RECORD

Give All Information Completely
Make Required Affidavit
Mail or Deliver Report to:
Conservation Division
State Corporation Commission
212 North Market, Insurance Bldg.
Wichita, Kansas

Logan County, Sec. 26 Twp. 11 Rge. 34 (E) W (W)

Location as "NE/CNW/SW" or footage from lines C - N - E - S - W
Lease Owner James OIL Co.
Lease Name Kenneth Reed Well No. 1
Office Address 12110 S. Western, Los Angeles, Calif.
Character of Well (completed as Oil, Gas or Dry Hole) Dry
Date well completed Sept. 3, 1960 19
Application for plugging filed Sept. 3, 1960 19
Application for plugging approved Sept. 3, 1960 19
Plugging commenced Sept. 3, 1960 19
Plugging completed Sept. 4, 1960 19
Reason for abandonment of well or producing formation Dry

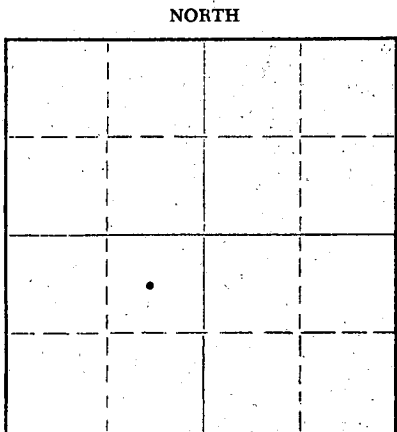

Locate well correctly on above Section Plat

If a producing well is abandoned, date of last production _____ 19____
Was permission obtained from the Conservation Division or its agents before plugging was commenced? yes

Name of Conservation Agent who supervised plugging of this well A.D. Fabricius
Producing formation None Depth to top _____ Bottom _____ Total Depth of Well 4780 Feet
Show depth and thickness of all water, oil and gas formations.

OIL, GAS OR WATER RECORDS

CASING RECORD

FORMATION	CONTENT	FROM	TO	SIZE	PUT IN	PULLED OUT
	220 ft.	0	220	8"	220	None

Describe in detail the manner in which the well was plugged, indicating where the mud fluid was placed and the method or methods used in introducing it into the hole. If cement or other plugs were used, state the character of same and depth placed, from _____ feet to _____ feet for each plug set.

Hole filled with 52 Vis Rotary Mud up to 500 feet, Rubber plug set with 20 Sacks of Cement.

Rotary Mud up to 250 ft with rubber plug set and 20 sacks cement up in surface casing.
bal of uper hole left open for land owner for water well.

RECEIVED
STATE CORPORATION COMMISSION
9-29-1960
SEP 29 1960
CONSERVATION DIVISION
Wichita, Kansas

(If additional description is necessary, use BACK of this sheet)

Name of Plugging Contractor Vernon L Baker Drlg Co
Address Box 276 Hamilton, Kansas

STATE OF Kansas, COUNTY OF Greenwood, ss.
Vernon L Baker Contractor (employee of owner) or (owner or operator) of the above-described well, being first duly sworn on oath, says: That I have knowledge of the facts, statements, and matters herein contained and the log of the above-described well as filed and that the same are true and correct. So help me God.

(Signature) Vernon L Baker
Box 276 Hamilton, Kansas (Address)

SUBSCRIBED AND SWORN to before me this 7th day of September, 1960

L. B. CAMPBELL, NOTARY PUBLIC
Greenwood County, Kansas
My Commission Expires August 15, 1964

L B Campbell
Notary Public.

James Oil

15-109-00003-00-00

DRILLERS LOG

26-11-34 W
CNE SW

0-75	Soil and clay
75-110	Sand
110-1600	Shale
1600-2120	Shale and shells
2120-2260	Red beds and shells
2260-2600	Shell and shale
2600-2980	Anhydrite
2980-3000	Shale and shells
3000-3495	Shale and lime
3495-4028	Shale and lime
4028-4670	Lime
4670-4680	Dolomite
4680-4685	Shale
4685-4780	Lime

T.D.: 4780

GEOLOGICAL TOPS

Heebner	4025
Toronto	4050
Lansing-Kansas City	4062
Base L. - K.C.	4374
Marmaton	4389
Cherokee	4540
Mississippi	4675

T. D. 4780

RECEIVED
STATE COMMISSION
9-29-1960
SEP 29 1960
CONSERVATION DIVISION
Wichita, Kansas

Vernon D Baker
Vernon Baker

STATE OF Kansas) ss.
COUNTY OF Greenwood)

On this the 2 day of Sept, 1960, before me, L.B. Campbell
appeared Vernon D. Baker known to me (or satisfactorily proven) to be the
person whose name is subscribed to the within (or foregoing)
instrument, and acknowledged that he executed the same for the
purposes therein contained.

In witness whereof, I hereunto set my hand and official seal.

My Commission Expires _____

L.B. Campbell

Notary Public

L. B. CAMPBELL, NOTARY PUBLIC
Greenwood County, Kansas
My Commission Expires August 15, 1964