

CARD MUST BE TYPED

State of Kansas
NOTICE OF INTENTION TO DRILL

CARD MUST BE SIGNED

15-143-20003-00-00

(see rules on reverse side)

Starting Date: 8/15/84
month day year

API Number 15-143-20,003

OPERATOR: License # 9661
Name Circle S, Inc.
Address Two Fairway Drive
City/State/Zip Hesston, Kansas 67062
Contact Person Mervin Schrag
Phone 316-327-4172

SW. SW. NE/4. Sec 33 Twp 12. S, Rge 4.
(location)
2970' Ft North from Southeast Corner of Section
2310' Ft West from Southeast Corner of Section
(Note: Locate well on Section Plat on reverse side)

East
 West

CONTRACTOR: License # 5927
Name Blackstone Drilling, Inc.
City/State P.O. Box 1184, McPherson, Ks. 67460

Nearest lease or unit boundary line 330' feet.
County Ottawa
Lease Name Oliver Well# 1
Domestic well within 330 feet: yes no
Municipal well within one mile: yes no

Well Drilled For: Well Class: Type Equipment:
 Oil Swd Infield Mud Rotary
 Gas Inj Pool Ext. Air Rotary
 OWWO Expl Wildcat Cable

Depth to Bottom of fresh water 200' feet
Lowest usable water formation
Depth to Bottom of usable water 200' feet
Surface pipe by Alternate: 1 2
Surface pipe to be set 200' feet
Conductor pipe if any required feet
Ground surface elevation feet MSL
This Authorization Expires 2-9-85
Approved By 8-9-84 [Signature]

If OWWO: old well info as follows:
Operator
Well Name
Comp Date Old Total Depth
Projected Total Depth 3760' feet
Projected Formation at TD Arbuckle
Expected Producing Formations Arbuckle

I certify that we will comply with K.S.A. 55-101, et seq., plus eventually plugging hole to K.C.C. specifications.

CIRCLE S, INC.


Date 8-7-84 Signature of Operator or Agent BY: Mervin W. Schrag Title President

MHC/KOHE 8/18/84

**Must be filed with the K.C.C. five (5) days prior to commencing well
This card void if drilling not started within six (6) months of date received by K.C.C.**

Important procedures to follow :

**A Regular Section of Land
1 Mile = 5,280 Ft.**

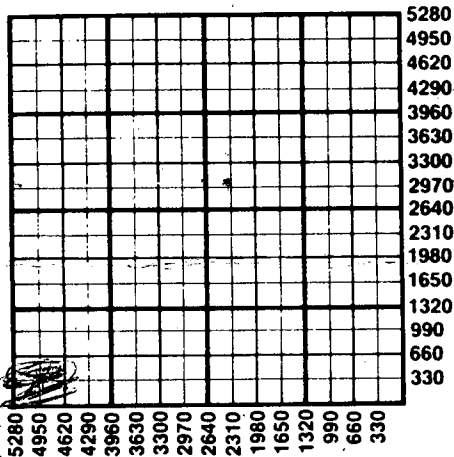

1. Notify District office before setting surface casing.
 2. Set surface casing by circulating cement to the top.
 3. File completion forms ACO-1 with K.C.C. within 90 days of well completion, following instructions on ACO-1, side 1, and including copies of wireline logs.
 4. Notify District office 48 hours prior to old well workover or re-entry.
 5. Prior to plugging, prepare a plugging plan, then obtain agreement from the appropriate district office for an approved plugging plan.
 6. Submit plugging report (CP-4) to K.C.C. after plugging is completed.
 7. Obtain an approved injection docket number before disposing of salt water.
- Notify K.C.C. within 10 days when injection commences or terminates. If an alternate 2 completion, cement in the production pipe from below any salt water to surface within 120 days of spud date.

CONSERVATION DIVISION
Wichita, Kansas

AUG 9 1984
8-9-1984

RECEIVED
STATE CORPORATION COMMISSION

**State Corporation Commission of Kansas
Conservation Division
200 Colorado Derby Building
Wichita, Kansas 67202
(316) 263-3238**