


STATE OF KANSAS  
STATE CORPORATION COMMISSION

15-109-20013-00-00

Form CP-4

Give All Information Completely  
Make Required Affidavit  
Mail or Deliver Report to:  
Conservation Division  
State Corporation Commission  
212 No. Market  
Wichita, Kansas 67202

WELL PLUGGING RECORD

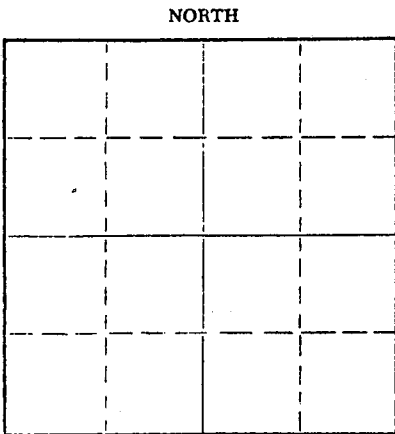

Locate well correctly on above  
Section Plat

Logan County. Sec. 34 Twp. 11S Rge. 37 (E) W (W)  
Location as "NE/CNW/SW" or footage from lines NW NW  
Lease Owner U.S. Signal Oil & Gas Co., 1971 Program  
Lease Name Collins Well No. 1  
Office Address 125 Central Building, Midland, Tx.  
Character of Well (completed as Oil, Gas or Dry Hole) D&A  
Date well completed 12-18-19 71  
Application for plugging filed 12-18-19 71  
Application for plugging approved 12-18-19 71  
Plugging commenced 12-18-19 71  
Plugging completed 12-18-19 71  
Reason for abandonment of well or producing formation D&A

If a producing well is abandoned, date of last production 19  
Was permission obtained from the Conservation Division or its agents before plugging was commenced? yes

Name of Conservation Agent who supervised plugging of this well W.L. Nichols  
Producing formation \_\_\_\_\_ Depth to top \_\_\_\_\_ Bottom \_\_\_\_\_ Total Depth of Well 5648 Feet  
Show depth and thickness of all water, oil and gas formations.

OIL, GAS OR WATER RECORDS

CASING RECORD

FORMATION	CONTENT	FROM	TO	SIZE	PUT IN	PULLED OUT
				8 5/8"	445'	-0-

Describe in detail the manner in which the well was plugged, indicating where the mud fluid was placed and the method or methods used in introducing it into the hole. If cement or other plugs were used, state the character of same and depth placed, from \_\_\_\_\_ feet to \_\_\_\_\_ feet for each plug set.

Filled hole with mud set plug @ 1650' cemented  
w/70 sx 50-50 pos 6% gel or 110 Cu. Ft., set  
plug @ 465' cemented w/25 sx or 30 Cu. Ft., set  
plug @ 40' cemented w/10 sx

RECEIVED  
STATE CORPORATION COMMISSION  
JAN 24 1972  
CONSERVATION DIVISION  
Wichita, Kansas


(If additional description is necessary, use BACK of this sheet)  
Name of Plugging Contractor Red Tiger Drilling Co.  
Address 1720 Wichita Plaza, Wichita, Ks.

STATE OF Kansas, COUNTY OF Sedgwick, ss.  
Jim Farrice (employee of owner) or (owner or operator) of the above-described

well, being first duly sworn on oath, says: That I have knowledge of the facts, statements, and matters herein contained and the log of the above-described well as filed and that the same are true and correct. So help me God.

(Signature) Jim Farrice  
1720 Wichita Plaza, Wichita, Ks.  
(Address)

Subscribed and Sworn to before me this 20th day of December, 19 71

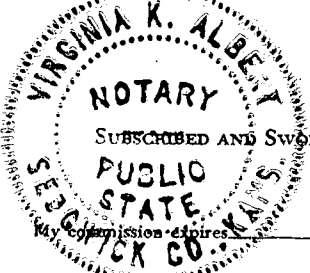

7-23-74

Notary Public.

15-109-~~100~~ 20013 -00-00

DRILLERS LOG

No. 1 Collins

CASING RECORD: 8 5/8" @ 445' w/300 sx cement  
 COMPANY: U.S. Signal Oil & Gas Co.-1971 Program  
 CONTRACTOR: Red Tiger Drilling Company  
 COMMENCED: November 29, 1971  
 COMPLETED: December 18, 1971

DESCRIPTION: NW NW 34-11S-37W Logan County, Kansas

TOTAL DEPTH: 5648'

ELEVATION:

<u>FORMATION</u>	<u>FROM</u>	<u>TO</u>	<u>REMARKS</u>
Clay & Shale	0	140	
Sand & Shale	140	225	
Blue Shale	225	447	
Shale	447	1515	
Shale & Sand	1515	1965	
Shale & Lime	1965	2110	
Sand	2110	2355	
Shale & Lime	2355	2380	
Sand	2380	2425	
Red Bed, Anhydrite & Blane	2425	2598	
Anhydrite	2598	2629	
Red Bed	2629	2705	
Shale	2705	2865	
Shale & Lime	2865	3040	
Shale	3040	3225	
Lime	3225	3285	
Lime & Shale	3285	3352	
Lime, Chert & Shale	3352	3420	
Lime	3420	3595	
Lime & Shale	3595	3810	
Lime	3810	4710	
Lime & Chert	4710	5080	
Lime, Chert & Chalk	5080	5135	
Lime & Chalk	5135	5190	
Cherty Lime	5190	5270	
Lime & Arbuckle	5270	5320	
Cherty Lime	5320	5510	
Lime	5510	5575	
Lime & Sand	5575	5648	

RECEIVED  
 STATE CORPORATION COMMISSION  
 1-24-1972  
 JAN 24 1972  
 CONSERVATION DIVISION  
 Wichita, Kansas

I certify that this is a true and correct copy of the above log to the best of my knowledge.

RED TIGER DRILLING COMPANY

*Jim Farrice*  
 Jim Farrice

Subscribed and sworn to before me this 20th day of December, 1971.

*Virginia K. Albert*  
 Notary Public



My Commission Expires:  
July 23, 1974