

15-199-00003-00-00


WELL PLUGGING RECORD

Give All Information Completely
Make Required Affidavit
Mail or Deliver Report to:
Conservation Division
State Corporation Commission
212 North Market, Insurance Bldg.
Wichita, Kansas

Wallace County, Sec. 21 Twp. 11S Rge. 41W (W)

Location as "NE/CNW/SW" or footage from lines NW NW
Lease Owner Natural Gas Drilling, Inc.
Lease Name HILL Well No. 1
Office Address 5101 North Pennsylvania, Oklahoma City 12, Oklahoma
Character of Well (completed as Oil, Gas or Dry Hole) Dry Hole
Date well completed November 10 1962
Application for plugging filed November 10 1962
Application for plugging approved November 10 1962
Plugging commenced November 10 1962
Plugging completed November 10 1962
Reason for abandonment of well or producing formation Dry Hole

NORTH

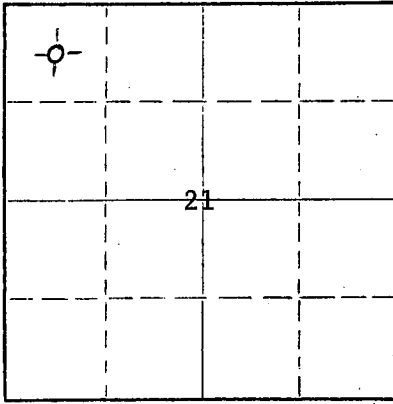

Locate well correctly on above Section Plat

If a producing well is abandoned, date of last production 19
Was permission obtained from the Conservation Division or its agents before plugging was commenced? Yes

Name of Conservation Agent who supervised plugging of this well Eldon Petty
Producing formation _____ Depth to top _____ Bottom _____ Total Depth of Well 5360 Feet
Show depth and thickness of all water, oil and gas formations.

OIL, GAS OR WATER RECORDS

CASING RECORD

FORMATION	CONTENT	FROM	TO	SIZE	PUT IN	PULLED OUT
Surface Casing		0	290'	8 5/8" OD		None

Describe in detail the manner in which the well was plugged, indicating where the mud fluid was placed and the method or methods used in introducing it into the hole. If cement or other plugs were used, state the character of same and depth placed, from _____ feet to _____ feet for each plug set.

0 - 30' Ten Sack cement plug
30 - 220' Heavy mud
220 - 280' 20 sack cement plug
280 - 5360' Heavy mud

RECEIVED
STATE CORPORATION COMMISSION
11-16-1962
NOV 13 1962
CONSERVATION DIVISION
Wichita, Kansas

(If additional description is necessary, use BACK of this sheet)
Name of Plugging Contractor Natural Gas Drilling, Inc.
Address 5101 North Pennsylvania, Oklahoma City 12, Oklahoma

STATE OF OKLAHOMA, COUNTY OF OKLAHOMA, ss.
L. L. BAKER (employee of owner) or (owner or operator) of the above-described well, being first duly sworn on oath, says: That I have knowledge of the facts, statements, and matters herein contained and the log of the above-described well as filed and that the same are true and correct. So help me God.

(Signature) L. L. Baker
5101 North Pennsylvania, Okla. City 12, Okla.
(Address)

SUBSCRIBED AND SWORN to before me this 14th day of November, 19 62
Marie Fitzgibbon
Notary Public.

My commission expires 2-16-66.



15-199-00003-00-00

DRILLERS LOG

Operator: NATURAL GAS DRILLING, INC.

HILL NO. 1
NW NW Sec. 21-11S-41W
Wallace County, Kansas

Commenced drilling October 28, 1962

Completed drilling November 9, 1962

8 5/8" surface casing set at 289 feet; cemented to surface with 225 sacks of cement.

Formation Record:

0 - 1160'	Soil; clay and shale
1160 - 1670'	Sand and shale
1670 - 3100'	Shale, sand and anhydrite
3100 - 3705'	Sand, shale and dolomite
3705 - 5090'	Lime and shale
5090 - 5250'	Shale and sand streaks
5250 - 5360'	Lime and dolomite
5360'	Total depth.

~~11-16-1962~~

Plugging Record:

11-16-1962

0 - 30'	Ten sack cement plug
30 - 220'	Heavy mud
220 - 280'	20 sack cement plug
280 - 5360'	Heavy mud

I hereby certify that the above and foregoing is a true and correct report of the drilling and abandonment of the well described.

Dated this 14th day of November, 1962.

L. L. Baker

Subscribed and sworn to before me, a Notary Public, this 14th day of November, 1962.

Marie Fitzgibbon
Notary Public

Plugging Inspector: Eldon Petty
Hays, Kansas