


STATE OF KANSAS
STATE CORPORATION COMMISSION

Give All Information Completely
Make Required Affidavit
Mail or Deliver Report to:
Conservation Division
State Corporation Commission
800 Bitting Building
Wichita, Kansas

OR
FORMATION PLUGGING RECORD

Strike out upper line
when reporting plug-
ging off formations.

NORTH

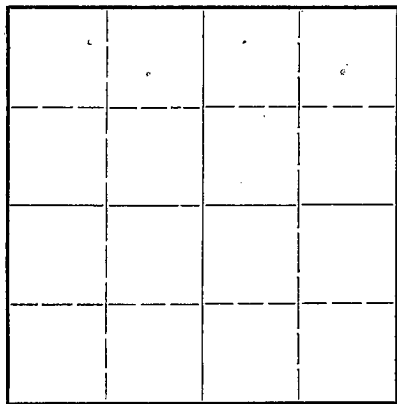

Locate well correctly on above
Section Plat

Ottawa County, Sec 34 Twp 12 Rge 3 (E) 16
Location as "NE 1/4 NW 1/4 SW 1/4" or footage from lines S.E. N.W. I/4
Lease Owner Central States Oil Co.,
Lease Name Moorman Brothers Well No. I
Office Address P. O. Box. 281. Salina. Kansas.
Character of Well (completed as Oil, Gas or Dry Hole) Dry Hole
Date well completed July. 31st. 19. 46
Application for plugging filed July. 28th. 19. 46
Application for plugging approved July. 31st. 19. 46
Plugging commenced July, 31st. 19. 46
Plugging completed July, 31st. 19.
Reason for abandonment of well or producing formation dry

If a producing well is abandoned, date of last production 19.
Was permission obtained from the Conservation Division or its agents before plugging was com-
menced? Yes

Name of Conservation Agent who supervised plugging of this well Ruel T. Durkee
Producing formation Depth to top Bottom Total Depth of Well 2982 Feet
Show depth and thickness of all water, oil and gas formations.

OIL, GAS OR WATER RECORDS


CASING RECORD

Formation	Content	From	To	Size	Put In	Pulled Out

Describe in detail the manner in which the well was plugged, indicating where the mud fluid was placed and the method or methods used in introducing it into the hole. If cement or other plugs were used, state the character of same and depth placed, from feet to feet for each plug set.

Filled hole with heavy mud, to Two Hundred feet of top.
Drove in plug, cemented with twenty sacks cement, and more mud to
12 feet of top, and then five sacks cement, and filled level with
mud.

PLUGGING
FILE 34 13 R 300
BOOK PAGE 63 LINE 40

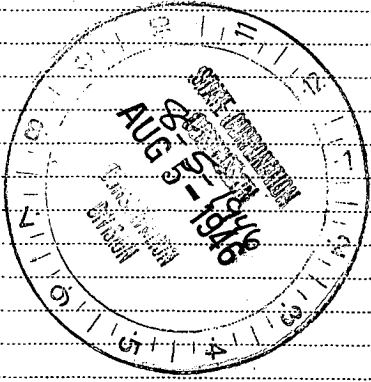

(If additional description is necessary, use BACK of this sheet)

Correspondence regarding this well should be addressed to Central States Oil Co., H. H. Meyer
Address P. O. Box. 281. Salina. Kansas.

STATE OF Kansas, COUNTY OF Saline, ss.
I. H. H. Meyer. (employee of owner) or (owner or operator) of the above-described well,
being first duly sworn on oath, says: That I have knowledge of the facts, statements, and matters herein contained and the log of the above-
described well as filed and that the same are true and correct. So help me God.

(Signature) I. H. H. Meyer
P O Box 281 Salina Kas (Address)
August, 1946
Margaret Gilbreath
Notary Public.

SUBSCRIBED AND SWORN TO before me this 3 day of August, 1946
My commission expires Jan 17, 1949

Company, Central States Oil Co.,
 Drilled, by self. H. H. Meyer. Cable Tools.
 Location, S. E. N. W. $\frac{1}{4}$, 34, 12. #11 Ottawa County, Kansas.
 Commenced, 7/20/43/ . Complte. 7/28/46. dry hole.

0	to	40	yellow clay
40	to	50	water sand
50	to	90	shale and shells
90		95	water sand, and gravel.
95		385	blue shale
385		395	lime
395		565	shale and red rock
565		850	shale and shells
850		1150	shale and lime
1150		1250	lime and sand,
1250		1277	gray and brown lime.
1277		1790	gray shale, very sticky.
1790		1795	hard brown lime
1795		1825	white lime
1825		1841	brown shale
1841		1863	cavy shale
1863		1895	shale and lime
1895		1925	blue shale
1925		1975	cavy shale blue and yellow.
1975		1977	coal
1977		1988	lime
1988		2008	soft gray lime
2008		2061	gray lime hard
2061		2066	coal
2066		2124	shale
2124		2160	sandy lime
2160		2195	gray shale
2195		2468	shale and lime
2468		2514	gray lime
2514		2580	brown shale
2580		2630	green and black shale
2630		2705	shale and shells
2705		2740	lime
2740		2780	cavy shale
2780		2805	brown shale
2805		2840	blue shale
2840		2900	shale and chert
2900		2920	hard lime
2920		2950	cavy shale
2950		2975	shale and chert
2975		2982	sandy lime.

2982. total depth.

Dry plugged and abandoned.

