

STATE OF KANSAS  
STATE CORPORATION COMMISSION

15-105-00011-00-00


WELL PLUGGING RECORD

Give All Information Completely  
Make Required Affidavit  
Mail or Deliver Report to:  
Conservation Division  
State Corporation Commission  
800 Bittling Building  
Wichita, Kansas

Lincoln County, Sec. 9 Twp. 12S Rge. 7 ~~W~~ W (W)

Location as "NE/CNW $\frac{1}{4}$ SW $\frac{1}{4}$ " or footage from lines SE NW SE  
Lease Owner Kenneth A. Ellison  
Lease Name Harms Well No. 1  
Office Address 222 N. E. 50th, Oklahoma City 5, Oklahoma  
Character of Well (completed as Oil, Gas or Dry Hole) Dry Hole  
Date well completed August 31 1952  
Application for plugging filed August 31 1952  
Application for plugging approved August 31 1952  
Plugging commenced August 31 1952  
Plugging completed August 31 1952  
Reason for abandonment of well or producing formation Dry Hole

NORTH

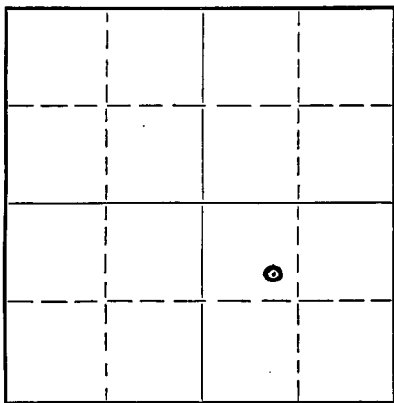

Locate well correctly on above Section Plat

If a producing well is abandoned, date of last production 19  
Was permission obtained from the Conservation Division or its agents before plugging was commenced? yes

Name of Conservation Agent who supervised plugging of this well Ruel Durkee  
Producing formation Arbuckle Depth to top 3800' Bottom Total Depth of Well 3820 Feet  
Show depth and thickness of all water, oil and gas formations.

OIL, GAS OR WATER RECORDS

CASING RECORD

Formation	Content	From	To	Size	Put In	Pulled Out
		Surface	360'	8 5/8"	363'	None

Describe in detail the manner in which the well was plugged, indicating where the mud fluid was placed and the method or methods used in introducing it into the hole. If cement or other plugs were used, state the character of same and depth placed, from feet to feet for each plug set.

Push bottom plug down 290' - build rock bridge and cement with 15 sacks through 9 joints of drill pipe. Top plug down 25' - cement with 5 sacks cement.

RECEIVED  
STATE CORPORATION COMMISSION  
9-6-1952  
SEP 8 - 1952

(If additional description is necessary, use BACK of this sheet)

Name of Plugging Contractor Penguin Petroleum, Inc.  
Address 709 Petroleum Building, Wichita, Kansas

STATE OF Kansas, COUNTY OF Sedgwick, ss.  
Maxine Lampe, agent of owner (employee of owner) or (owner or operator) of the above-described well, being first duly sworn on oath, says: That I have knowledge of the facts, statements, and matters herein contained and the log of the above-described well as filed and that the same are true and correct. So help me God.

(Signature) Maxine Lampe

(Address)

SUBSCRIBED AND SWORN to before me this 3rd day of September 7, 1952

My commission expires November 1, 1953

23-8390-s 6-51-20M

Jaye English  
Notary Public.

PLUGGING  
FILE SEC 9 T 12 R 12  
BOOK PAGE 42 LINE 11

15-105-00011-00-00

Company: Kenneth A. Ellison  
Farm: Farms #1  
Comm: August 15, 1952  
Comp: August 31, 1952  
Contractor: Penguin Petroleum, Inc.

Sec. 9, T 12S, R 7W  
SE 1/4 SE  
Lincoln County, Kansas  
Rotary Tools:  
Elevation: 1360' D. F.  
Rotary Total Depth: 3520'

Casings: 6 5/8" @ 360' cas/260 sz.

0-20	Surface dirt, clay & sand
-50	Hard lime rock or quartzite
-70	Red bed & shells
-95	Red bed
-225	Shale
-360	Sandy shale & gypsum
-460	Red bed
-1040	Shale & shells
-1095	Shale & lime
-1110	Lime & shale
-1460	Sandy lime & shale
-1795	Shale & shells
-2060	Lime & shale
-2175	Lime
-2195	Lime & shale
-2295	Lime
-2355	Sandy lime & shale
-2435	Lime & shale
-2542	Shale & lime
-2620	Lime & shale
-2695	Lime
-2747	Lime & shale
-2800	Lime
-2800	Lime, shale & sand
-3012	Lime & shale
-3131	Shale & lime
-3292	Lime & chert
-3336	Lime & shale
-3414	Shale
-3475	Lime
-3517	Lime & shale
-3565	Shale
-3582	Shale & lime
-3723	Lime
-3756	Sand & shale
-3816	Sand, shale & lime
-3880	Lime

R.T.L. 3520'

Top:	Kansas City	2417'	Hunton	3405'
	Conglomerate	3038'	Maquoketa	3432'
	Mississippi	3137'	Viola	3592'
	Kinderhook	3297'	Simpson	3718'
	Kinderhook Shale	3357'	Arbuckle	3800'

Certified to be a true copy of the well log as indicated on daily drilling reports.

PENGUIN PETROLEUM, INC.

*Maryanne Lamp*  
Assistant Secretary

Subscribed and sworn to before me, the undersigned, a Notary Public in and for Sedgewick County, Kansas, this 2nd day of September, 1952.

My Commission Expires:

November 1, 1953

*Jay E. English*  
Notary Public