


15-199-00013-00-00

WELL PLUGGING RECORD

Give All Information Completely
Make Required Affidavit
Mail or Deliver Report to:
Conservation Division
State Corporation Commission
800 Bitting Building
Wichita, Kansas

Wallace County, Sec. 36 Twp. 11 Rge. (E) 42 (W)
Location as "NE/CNW%SW%" or footage from lines NW-NW of SE
Lease Owner O. G. Martin
Lease Name Hill Well No. 1
Office Address Shreveport, Louisiana
Character of Well (completed as Oil, Gas or Dry Hole) Dry Hole
Date well completed January 26, 19 54
Application for plugging filed January 27, 19 54
Application for plugging approved January 27, 19 54
Plugging commenced January 28, 19 54
Plugging completed January 28, 19 54
Reason for abandonment of well or producing formation Dry Hole

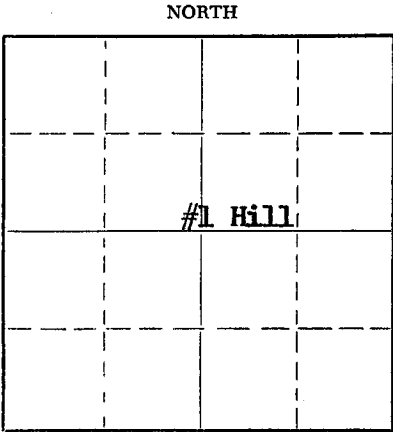

Locate well correctly on above
Section Plat

If a producing well is abandoned, date of last production None 19
Was permission obtained from the Conservation Division or its agents before plugging was commenced? Yes

Name of Conservation Agent who supervised plugging of this well Eldon Petty Hays, Kan.
Producing formation None Depth to top _____ Bottom _____ Total Depth of Well 5233 Feet
Show depth and thickness of all water, oil and gas formations.

OIL, GAS OR WATER RECORDS

CASING RECORD

FORMATION	CONTENT	FROM	TO	SIZE	PUT IN	PULLED OUT
Red Bed		300	328	10 3/4"	328	None

Describe in detail the manner in which the well was plugged, indicating where the mud fluid was placed and the method or methods used in introducing it into the hole. If cement or other plugs were used, state the character of same and depth placed, from _____ feet to _____ feet for each plug set.

Hole was full of heavy mud and 25 sax cement was pumped in at 300' and then casing was filled to top with cement using 35 sax.

2-17-1954

(If additional description is necessary, use BACK of this sheet)

Name of Plugging Contractor Halliburton
Address Duncan, Oklahoma

STATE OF Texas, COUNTY OF Wichita, ss.
O. G. Martin Dee Ford (employee of owner) or (owner or operator) of the above-described well, being first duly sworn on oath, says: That I have knowledge of the facts, statements, and matters herein contained and the log of the above-described well as filed and that the same are true and correct. So help me God.

(Signature) Dee Ford
Wichita Falls, Texas
(Address)

SUBSCRIBED AND SWORN TO before me this 16th day of February, 1954
W. C. Runtz
Notary Public.

My commission expires 6-1-55

24-2675-S 2-52-20M

PLUGGING
FILE SEC 36 T 11 R 42W
BOOK PAGE 11 LINE 15

DRILLERS LOG
HILL #1
WALLACE CO., KANSAS

36-11-42W

Formation	From	To
Surface Sand & Clay	0	30
Sandy Shale	30	365
Shale & Sand	365	1304
Shale	1304	2058
Sandy Shale	2058	2190
Lime & Shells	2190	2210
Shale & Shells	2210	2510
Sand & Shale	2510	2665
Lime	2665	2689
Shale	2689	2696
Shale & Lime	2696	2800
Sand	2800	2878
Shale & Sand	2878	2940
Shale	2940	2973
Lime & Shale	2973	3111
Shale	3111	3251
Shale; Hard Sand & Lime	3251	3346
Shale & Sand	3346	3392
Shale	3392	3425
Shale & Lime	3425	3525
Dolomite & Sand	3525	3574
Sand & Shale	3574	3623
Lime & Sand	3623	3656
Shale & Sand	3656	3686
Lime	3686	3702
Cherty Lime	3702	3735
Lime	3735	3815
Lime; Shale & Anhy	3815	3845
Lime	3845	3896
Lime & Shale	3896	3921
Lime	3921	3982
Shale & Lime	3982	4012
Lime	4012	4085
Shale & Lime	4085	4234
Lime (Slight Odor)	4234	4262
Shale & Shells	4262	4315
Lime	4315	4431
Cherty Lime	4431	4500
Lime	4500	4588
Lime & Dolomite	4588	4658
Lime & Sand	4658	4710
Lime	4710	4751
Lime & Shale	4751	4803
Lime	4803	4846
Lime & Lignite	4846	4875
Cherty Lime	4875	4890
Lime	4890	4916
Shaly Lime & Chert Stks.	4916	4948
Cherty Lime	4948	4983
Lime & Chert	4983	5007
Shale & Lime	5007	5048
Shale	5048	5070
Lime	5070	5111
Cherty Lime & Shale Stks.	5111	5137
Shale & Lime	5137	5172
Lime	5172	5190
Lime; Chert & Dolo.	5190	5209
Dolo. & Shale	5209	5233

3811
449
4260

2-17-1954

PLUGGING

FLK SEC 36 T 11 R 11
BOOK PAGE 11 LINE 15