

STATE OF KANSAS
STATE CORPORATION COMMISSION

WELL PLUGGING RECORD

OR

FORMATION PLUGGING RECORD

Strike out upper line when reporting plugging off formations.

Give All Information Completely
Make Required Affidavit
Mail or Deliver Report to:
Conservation Division
State Corporation Commission
800 Bitting Building
Wichita, Kansas

Russell County. Sec. 29 Twp 12 Rge. 13 (E) (W)

Location as "NE $\frac{1}{4}$ NW $\frac{1}{4}$ SW $\frac{1}{4}$ " or footage from lines. SESWSW ANB KC

Lease Owner BEN. F. BRACK Oil & Inc

Lease Name Wenger Well No. 1

Office Address 309-10 Brown Bldg Wichita Ks.

Character of Well (completed as Oil, Gas or Dry Hole)

Date well completed 3-31 1948

Application for plugging filed 3-31 1948

Application for plugging approved 3-31 1948


Plugging commenced 3-31 1948

Plugging completed 3-31 1948

Reason for abandonment of well or producing formation DRY Hole

If a producing well is abandoned, date of last production 19

Was permission obtained from the Conservation Division or its agents before plugging was commenced? Yes

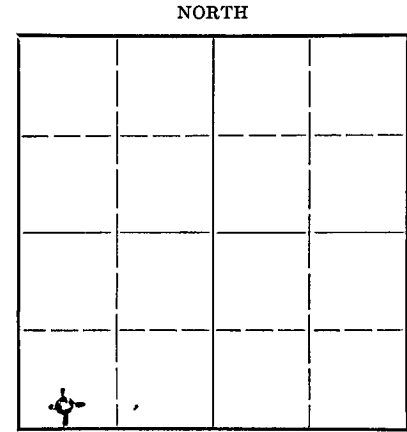

Locate well correctly on above Section Plat

Name of Conservation Agent who supervised plugging of this well O. D. Stough

Producing formation ARB Depth to top 3207 Bottom 3257 Total Depth of Well 3257 Feet

Show depth and thickness of all water, oil and gas formations.

OIL, GAS OR WATER RECORDS

CASING RECORD

Formation	Content	From	To	Size	Put In	Pulled Out
<u>SURFACE SOIL</u> <u>AND IRON PYRITES</u>		<u>0-157</u>	<u>157</u>	<u>10 1/2</u>	<u>1 1/4</u>	<u>NONE</u>

Describe in detail the manner in which the well was plugged, indicating where the mud fluid was placed and the method or methods used in introducing it into the hold. If cement or other plugs were used, state the character of same and depth placed, from 114 feet to 20 feet for each plug set.

CONNED PITS LOADED Hole To Bottom of SURFACE Pipe with Heavy Mud. Pushed Plug To 114' and CEMENTED with 15 SAK PORTLAND. Filled with MOD TO 20' set Plug - 10 SAK PORTLAND ON TOP OF SAME.

APR - 6 1948
04-06-48

(If additional description is necessary, use BACK of this sheet)

Correspondence regarding this well should be addressed to BEN. F. BRACK Oil & Inc
Address 309-10 Brown Bldg Wichita Ks.

STATE OF _____, COUNTY OF _____, ss.

_____ (employee of owner) or (owner or operator) of the above-described well, being first duly sworn on oath, says: That I have knowledge of the facts, statements, and matters herein contained and the log of the above-described well as filed and that the same are true and correct. So help me God.

(Signature) Frank Brack

SUBSCRIBED AND SWORN to before me this 5th day of April, 1948

(Address) Maxine Underwood
Notary Public.

My commission expires September 19, 1951

PLUGGING
FILE SEC 29 T 17 R 13 W
BOOK PAGE 20 LINE 22

WELL LOG

BEN F. BRACK OIL COMPANY, INC.

Wenger # 1

C S $\frac{1}{2}$ of the S $\frac{1}{2}$ of
the SW $\frac{1}{4}$ of 29-12-
13, Russell CountyDate Comm: 2-28-48
Date Comp: 4-1-48

sand & shells	75
sand & shells	100
iron & hard sand	110
hard sand	120
sand	120
hard sand & pyrite	145
hard sand	150
hard sand & iron	160
red bed & sand	170
red bed	580
lime, shells & anhydrite	580 670
shale & shells	900
shale, shells & salt	1215
salt, shale & broken lime	1410
sandy lime & shale	1515
lime & shale	1620
lime & shale	1705
lime & shale	1875
lime & shale	1985
lime & shale	2155
lime & shale & shells	2350
lime & shale	2350
lime & shale	2450
lime	2662
lime	2701
lime & shale	2869
lime	2900
lime	2961
lime & shale	2782
lime & shale	2784
lime	3017
lime	3065
lime	3102
Cherty lime & shale	3158
sandy lime & shale	3206
sand, lime & shale	3207
Arbuckle lime	3207
Arbuckle lime	3250
Arbuckle lime	3257
Total Depth:	3257

PLUGGINGFILE SEC 29T-17R-13WBOOK PAGE 20 LINE 22