

CARD MUST BE TYPED

State of Kansas
NOTICE OF INTENTION TO DRILL

(see rules on reverse side)

Correction

~~7-16~~ CARD MUST BE SIGNED

Starting Date: 7 15 1985
month day year

API Number 15- 167-22,629 -00-00

OPERATOR: License # 9860

SE SE SE Sec 19 Twp 12 S, Rge 13 East
(location) West

Name Castle Resources

Address R.R. 1, Lot 8, Stonewood Estates

City/State/Zip Hays, KS 67601

Contact Person Jerry Green (or J.R. Green)

Phone (913) 625-5155

330 Ft North from Southeast Corner of Section
330 Ft West from Southeast Corner of Section
(Note: Locate well on Section Plat on reverse side)

CONTRACTOR: License # 5381

Name Big Springs Drilling

City/State Wichita, KS 67202

Nearest lease or unit boundary line 330 feet.

County Russell

Lease Name Paradise Creek Well# 1

Domestic well within 330 feet: yes no

Municipal well within one mile: yes no

Well Drilled For: Well Class: Type Equipment:

- Oil Swd Infield Mud Rotary
- Gas Inj Pool Ext. Air Rotary
- OWWO Expl Wildcat Cable

Depth to Bottom of fresh water 75 feet

Lowest usable water formation Dakota

Depth to Bottom of usable water 600 feet

Surface pipe by Alternate: 1 2

Surface pipe to be set 210 feet

Conductor pipe if any required feet

Ground surface elevation 1553 feet MSL

This Authorization Expires 1-11-86

Approved By 7-11-85

If OWWO: old well info as follows:

Operator

Well Name

Comp Date Old Total Depth

Projected Total Depth 3250 feet

Projected Formation at TD

Expected Producing Formations

I certify that we will comply with K.S.A. 55-101, et seq., plus eventually plugging hole to K.C.C. specifications.

Date 7/15/85 Signature of Operator or Agent

Luanne Cortes

Title As. Agent

Add. charge


SS-51-LO

JUL 15 1985

Important procedures to follow:

CONSERVATION DIVISION

A Regular Section of Land
1 Mile = 5,280 Ft.

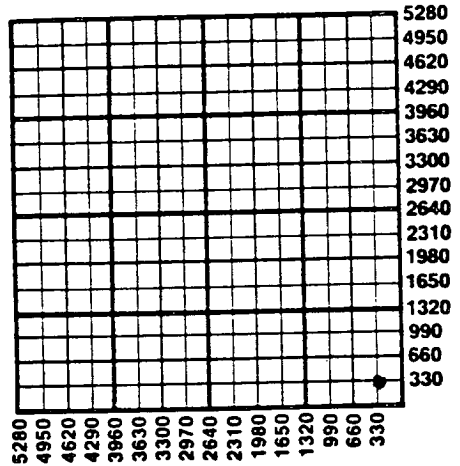

1. Notify District office before setting surface casing
2. Set surface casing by circulating cement to the top.
3. File completion forms ACO-1 with K.C.C. within 90 days of well completion, following instructions on ACO-1, side 1, and including copies of wireline logs.
4. Notify District office 48 hours prior to old well workover or re-entry.
5. Prior to plugging, prepare a plugging plan, then obtain agreement from the appropriate district office for an approved plugging plan.
6. Submit plugging report (CP-4) to K.C.C. after plugging is completed.
7. Obtain an approved injection docket number before disposing of salt water.
8. Notify K.C.C. within 10 days when injection commences or terminates.
9. If an alternate 2 completion, cement in the production pipe from below any usable water to surface within 120 days of spud date.

State Corporation Commission of Kansas
 Conservation Division
 200 Colorado Derby Building
 Wichita, Kansas 67202
 (316) 263-3238