

CARD MUST BE TYPED

State of Kansas

CARD MUST BE SIGNED

NOTICE OF INTENTION TO DRILL

(see rules on reverse side)

"CORRECTED INTENT"

Starting Date May 1, 1987 month day year

API Number 15- 167-22,778 - 00 - 00 4-30-87
Approx. East
NE. SW. NW... Sec. 27.. Twp.. 12. S, Rg.. 13... X West
3630 Ft. from South Line of Section
4290 Ft. from East Line of Section

OPERATOR: License # 3345
Name Leroy E. Tobias
Address H.C. 69 Box 42
City/State/Zip Bunker Hill, KS 67626
Contact Person Leroy E. Tobias
Phone (913)-483-4565

(Note: Locate well on Section Plat on reverse side)
Nearest lease or unit boundary line 330 feet
County Russell
Lease Name Tobias Well # 1
Ground surface elevation 1543 feet MSL
Domestic well within 330 feet: yes X no

CONTRACTOR: License # 8241
Name Emphasis Oil Operations
City/State P. O. Box 506, Russell, KS 67665-0506

Municipal well within one mile: yes X no
Depth to bottom of fresh water 60
Depth to bottom of usable water 200'
Surface pipe by Alternate: 1 X 2
Surface pipe planned to be set 250'
Conductor pipe required N/A
Projected Total Depth 3450 feet
Formation Arbuckle

Well Drilled For: Well Class: Type Equipment:
X Oil SWD Infield X Mud Rotary
Gas Inj Pool Ext Air Rotary
OWWO Expl X Wildcat Cable

If OWWO: old well info as follows:
Operator
Well Name
Comp Date Old Total Depth

I certify that well will comply with K.S.A. 55-101, et seq., plus eventually plugging hole to KCC specifications.
Date 4-28-87 Signature of Operator or Agent Title Agent 4950 FEL

For KCC Use:
Conductor Pipe Required feet; Minimum Surface Pipe Required 250 feet per Alt. 1
This Authorization Expires 10-21-87 Approved By 4-21-87


Must be filed with the K.C.C. five (5) days prior to commencing well
 This card void if drilling not started within six (6) months of date received by K.C.C.

Important procedures to follow:

1. Notify District office before setting surface casing.
2. Set surface casing by circulating cement to the top.
3. File completion forms ACO-1 with K.C.C. within 90 days of well completion, following instructions on ACO-1, side 1, and including copies of wireline logs.
4. Notify District office 48 hours prior to old well workover or re-entry.
5. Prior to filing Intent, prepare a proposed plugging plan in case well is D & A, then obtain approval of plan when calling district office prior to setting surface pipe.
6. Submit plugging report (CP-4) to K.C.C. after plugging is completed.
7. Obtain an approved injection docket number before disposing of salt water.
8. Notify K.C.C. within 10 days when injection commences or terminates.
9. If an alternate 2 completion, cement in the production pipe from below any usable water to surface within 120 days of spud date.

**A Regular Section of Land
 1 Mile = 5,280 Ft.**

Approx:

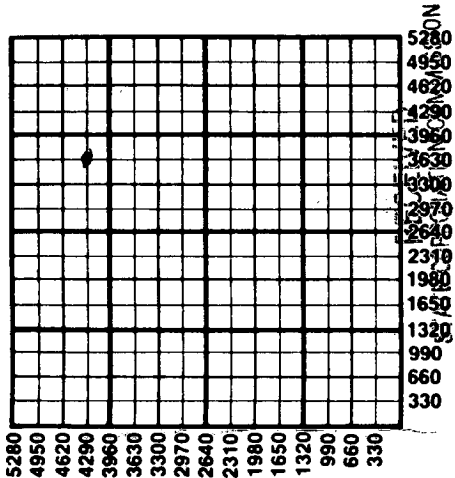

APR 29 1987
 CONSERVATION DIVISION
 Wichita, Kansas
 40-29-87

State Corporation Commission of Kansas
 Conservation Division
 200 Colorado Derby Building
 Wichita, Kansas 67202
 (316) 263-3238