

NOTICE OF INTENTION TO DRILL

(see rules on reverse side)

Starting Date ..... 02 20 87
month day year

API Number 15- 167-22,765-00-00

OPERATOR: License # 4668
Name Seville Drilling Corporation
Address P.O. Box 668
City/State/Zip La. Crosse, Ks. 67548
Contact Person D.L. Stegman
Phone 913-222-2633

SW NW NE Sec. 36 Twp. 11 S, Rg. 15 West
4290 Ft. from South Line of Section
2310 Ft. from East Line of Section

(Note: Locate well on Section Plat on reverse side)

CONTRACTOR: License # 4083
Name Western Kansas Drilling, Inc
City/State Hays, Kansas

Nearest lease or unit boundary line 330 feet
County Russell

Lease Name Hartman Well # 1

Ground surface elevation 1810 feet MSL

Well Drilled For: Well Class: Type Equipment:
X Oil SWD Infield X Mud Rotary
Gas Inj Pool Ext Air Rotary
OWWO Expl X Wildcat Cable

Domestic well within 330 feet: yes X no
Municipal well within one mile: yes X no
Depth to bottom of fresh water 180
Depth to bottom of usable water 475

Surface pipe by Alternate: 1 X 2

If OWWO: old well info as follows:
Operator
Well Name
Comp Date Old Total Depth

Surface pipe planned to be set 900
Conductor pipe required none
Projected Total Depth 3300 feet
Formation Arbuckle

I certify that well will comply with K.S.A. 55-101, et seq., plus eventually plugging hole to KCC specifications.
Date 01-05-87 Signature of Operator or Agent Title Expl. & Prod. Manager

For KCC Use:
Conductor Pipe Required feet; Minimum Surface Pipe Required 500 feet per Alt. 1 & 4
This Authorization Expires 7-8-87 Approved By 1-8-87


Handwritten signature at bottom right.

Must be filed with the K.C.C. five (5) days prior to commencing well  
This card void if drilling not started within six (6) months of date received by K.C.C.

**Important procedures to follow:**

1. Notify District office before setting surface casing.
2. Set surface casing by circulating cement to the top.
3. File completion forms ACO-1 with K.C.C. within 90 days of well completion, following instructions on ACO-1, side 1, and including copies of wireline logs.
4. Notify District office 48 hours prior to old well workover or re-entry.
5. Prior to filing Intent, prepare a proposed plugging plan in case well is D & A, then obtain approval of plan when calling district office prior to setting surface pipe.
6. Submit plugging report (CP-4) to K.C.C. after plugging is completed.
7. Obtain an approved injection docket number before disposing of salt water.
8. Notify K.C.C. within 10 days when injection commences or terminates.
9. If an alternate 2 completion, cement in the production pipe from below any usable water to surface within 120 days of spud date.

**A Regular Section of Land  
1 Mile = 5,280 Ft.**

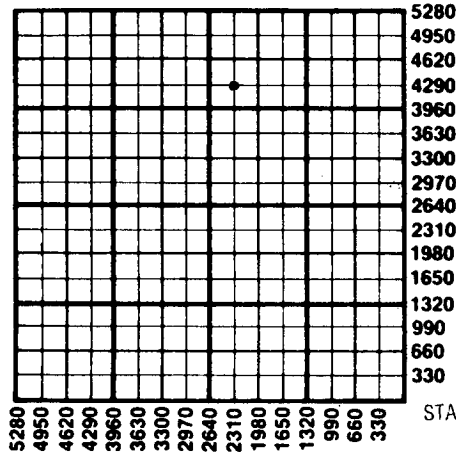

STATE CORPORATION COMMISSION

JAN 8 1987  
1-8-1987  
CONSERVATION DIVISION  
Wichita, Kansas

State Corporation Commission of Kansas  
Conservation Division  
200 Colorado Derby Building  
Wichita, Kansas 67202  
(316) 263-3238