

Correction

FORM MUST BE FILED
FORM C-1 4/90

EFFECTIVE DATE: 9-4-90

State of Kansas
NOTICE OF INTENTION TO DRILL

FORM MUST BE SIGNED
ALL BLANKS MUST BE FILLED

Must be approved by the K.C.C. five (5) days prior to commencing well

Expected Spud Date: 09/01/90
month day year
52 S2 SE Sec 27 Twp 11 S Rg 15 W West

OPERATOR: License # 6194
330 feet from South Line of Section
1300 feet from East Line of Section
(Note: Locate well on Section Plat on Reverse Side)

Name: ESP DEVELOPMENT, INC.
Address: RR #1 BOX 18
City/State/Zip: PARADISE KA 67658
Contact Person: BUD EULERT
Phone: (913) 998-4413

County: RUSSELL
Lease Name: EULERT N W
Field Name: WILDCAT
Well # 1

CONTRACTOR: License # 4083
Name: WESTERN KANSAS DRILLING

Is this a Prorated Field? yes no
Target Formation(s): ARBUCKLE
Nearest lease or unit boundary: 330
Ground Surface Elevation: 1783 feet MSL
Domestic well within 330 feet: yes no
Municipal well within one mile: yes no
Depth to bottom of fresh water: 200
Depth to bottom of usable water: 750
Surface Pipe by Alternate: 1 2
Length of Surface Pipe Planned to be set: 200
Length of Conductor Pipe required: *****
Projected Total Depth: 3450
Formation at Total Depth: ARBUCKLE
Water Source for Drilling Operations:
well farm pond other

Well Drilled For: Well Class: Type Equipment:
XX Oil Inj Infield XX Mud Rotary
Gas Storage Pool Ext Air Rotary
OWWO Disposal XX Wildcat Cable
Seismic; # of Holes

If OWWO; old well information as follows:

Operator:
Well Name:
Comp Date: Old Total Depth:

Directional, Deviated or Horizontal Wellbore? yes no
If yes, total depth location:

WAS-8 Lease - B. Eulert Ranch

AFFIDAVIT IS: Eulert NW

The undersigned hereby affirms that the drilling, completion and eventual plugging of this well will comply with K.S.A. 55-101, et. seq.

It is agreed that the following minimum requirements will be met:

- 1. The appropriate district office shall be notified before setting surface pipe;
- 2. The minimum amount of surface pipe as specified above shall be set by circulating cement to the top; in all cases surface pipe shall be set through all unconsolidated materials plus a minimum of 20 feet into the underlying formation;
- 3. If the well is dry, a plugging proposal shall be submitted to the district office. An agreement between the operator and the district office on plug length and placement is necessary prior to plugging;
- 4. The appropriate district office will be notified before well is either plugged or production casing is cemented in;
- 5. If an Alternate II completion, production pipe shall be cemented from below any usable water to surface within 120 days of spud date. In all cases, notify district office prior to any cementing.

I hereby certify that the statements made herein are true and to the best of my knowledge and belief.

Date: 08/30/90 Signature of Operator or Agent: [Signature] Title: AGENT

FOR KCC USE 67-22,924
API # 15- 1167-22,924-00-00
Conductor Pipe required None feet
Minimum surface pipe required 200 feet per Alt. (2)
Approved by: [Signature] DRIG 8-30-90
EFFECTIVE DATE: 9-4-90
This authorization expires: 2-28-91
(This authorization void if drilling not started within 6 months of effective date.)
Spud date: Agent:

RECEIVED
STATE CORPORATION COMMISSION
9-5-1990
SEP 5 1990
CONSERVATION DIVISION
Wichita, Kansas

- REMEMBER TO:
- File Drill Pit Application (form CDP-1) with Intent to Drill;
 - File Completion Form ACO-1 within 120 days of spud date;
 - File acreage attribution plat according to field proration orders;
 - Notify appropriate district office 48 hours prior to workover or re-entry;
 - Submit plugging report (CP-4) after plugging is completed;
 - Obtain written approval before disposing or injecting salt water.

27
11
1510

PLAT OF ACREAGE ATTRIBUTABLE TO A WELL


State Corporation Commission, Conservation Division
200 Colorado Derby Bldg. Wichita, Kansas 67202

OPERATOR ESP DEVELOPMENT, INC. LOCATION OF WELL:
 LEASE EULERT N W 330 feet north of SE corner
 WELL NUMBER #1 1300 feet west of SE corner
 FIELD WILDCAT SE Sec. 27 T 11 R 15 *W*
 COUNTY RUSSELL
 NO. OF ACRES ATTRIBUTABLE TO WELL _____ IS SECTION REGULAR IRREGULAR?
 DESCRIPTION OF ACREAGE SE IF IRREGULAR, LOCATE WELL FROM NEAREST CORNER BOUNDARY.

NOTE: If plat depicted is insufficient for your circumstances, you may attach your own scaled or surveyed plat.

non-prorated field *

PLAT

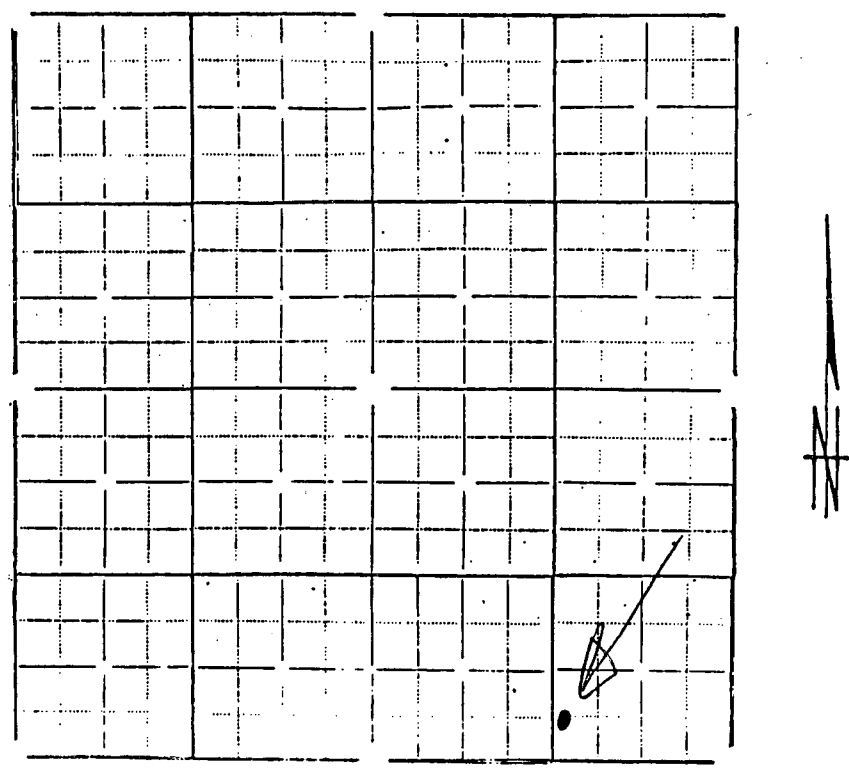

In plotting the proposed location of the well, you must show:

- 1) The manner in which you are using the depicted plat by identifying section lines, i.e. 1 section, 1 section with 8 surrounding partial sections, 4 sections, 16 sections, etc.;
- 2) the well's location relative to the location of other wells producing from the same common source of supply in adjoining drilling units, pursuant to K.A.R. 82-3-108, 82-3-207, 82-3-312, or special orders of the Commission;
- 3) the distance of the proposed drilling location from the section's east and south lines; and
- 4) the distance to the nearest lease or unit boundary line.

I hereby certify that the statements made herein are true and to the best of my knowledge and belief.

Signature of Operator or Agent *[Signature]*
 Date 08/30/90 Title SEARCH, INC. PAS AGENT