

CARD MUST BE TYPED

State of Kansas  
**NOTICE OF INTENTION TO DRILL**  
(see rules on reverse side)

CARD MUST BE SIGNED

Starting Date: ..... 6 ..... 3 ..... 85 .....  
month day year (11.27)

API Number 15- 167-22,615-00-00

**OPERATOR:** License # 5146  
Name Rains & Williamson Oil Co., Inc.  
Address 435 Page Court, 220 West Douglas  
City/State/Zip Wichita, Kansas 67202  
Contact Person Juanita Green  
Phone (316) 265-9686

NE SW NE Sec 1 Twp 12 S, Rge 14  
(location)  East  West

3630 Ft North from Southeast Corner of Section  
1650 Ft West from Southeast Corner of Section  
(Note: Locate well on Section Plat on reverse side)

**CONTRACTOR:** License # 5146  
Name Same as Above  
City/State .....

Nearest lease or unit boundary line ..... 330 ..... feet.  
County Russell  
Lease Name ZWEIFEL "A" Well # 1

**Well Drilled For:** **Well Class:** **Type Equipment:**  
 Oil  Swd  Infield  Mud Rotary  
 Gas  Inj  Pool Ext.  Air Rotary  
 OWWO  Expl  Wildcat  Cable

Domestic well within 330 feet :  yes  no  
Municipal well within one mile :  yes  no

If OWWO: old well info as follows:  
Operator .....  
Well Name .....  
Comp Date ..... Old Total Depth .....  
Projected Total Depth 3350' ..... feet  
Projected Formation at TD Lansing/Kansas City  
Expected Producing Formations Lansing/Kansas City

Depth to Bottom of fresh water ..... 75 ..... feet  
Lowest usable water formation ..... Dakota .....  
Depth to Bottom of usable water ..... 525 340 ..... feet  
Surface pipe by Alternate : 1  2   
Surface pipe to be set ..... 290 340 ..... feet  
Conductor pipe if any required ..... -0- ..... feet  
Ground surface elevation ..... feet MSL  
This Authorization Expires 11-30-85  
Approved By 5-30-85 [Signature]

I certify that we will comply with K.S.A. 55-101, et seq., plus eventually plugging hole to K.C.C. specifications.

Date 5-30-85 Signature of Operator or Agent [Signature] Title


PRESIDENT  
[Signature]  
RCH FOR KODE  
Form C-1 4/84

RECEIVED  
STATE CORPORATION COMMISSION

Must be filed with the K.C.C. five (5) days prior to commencing well  
and void if drilling not started within six (6) months of date received by K.C.C.

MAY 30 1985  
05-30-85

Wichita, Kansas  
A Regular Section of Land  
1 Mile = 5,280 Ft.

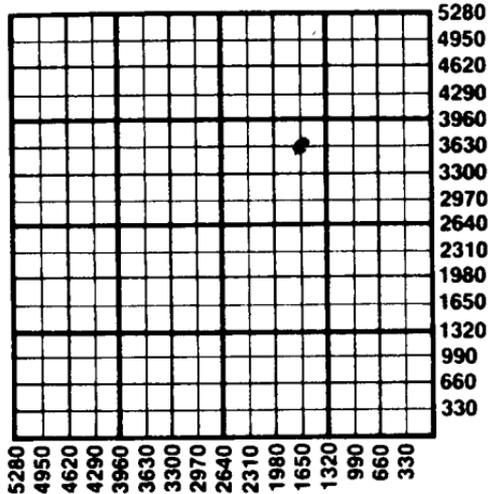

**Important procedures to follow :**

1. Notify District office before setting surface casing.
2. Set surface casing by circulating cement to the top.
3. File completion forms ACO-1 with K.C.C. within 90 days of well completion, following instructions on ACO-1, side 1, and including copies of wireline logs.
4. Notify District office 48 hours prior to old well workover or re-entry.
5. Prior to plugging, prepare a plugging plan, then obtain agreement from the appropriate district office for an approved plugging plan.
6. Submit plugging report (CP-4) to K.C.C. after plugging is completed.
7. Obtain an approved injection docket number before disposing of salt water.
8. Notify K.C.C. within 10 days when injection commences or terminates.
9. If an alternate 2 completion, cement in the production pipe from below any usable water to surface within 120 days of spud date.

State Corporation Commission of Kansas  
Conservation Division  
200 Colorado Derby Building  
Wichita, Kansas 67202  
(316) 263-3238