

CARD MUST BE TYPED

State of Kansas
NOTICE OF INTENTION TO DRILL

CARD MUST BE SIGNED

(see rules on reverse side)

Starting Date: 8 20 84
month day year

API Number 15- 167-22,442-00-00

OPERATOR: License # 5146

N/2 NE NE Sec 8 Twp 12 S, Rge 14 East
(location) West

Name Rains & Williamson Oil Co., Inc.

Address 435 Page Court, 220 West Douglas

City/State/Zip Wichita, Kansas 67202

Contact Person Juanita Green

Phone (316) 265-9686

4950 Ft North from Southeast Corner of Section

660 Ft West from Southeast Corner of Section

(Note: Locate well on Section Plat on reverse side)

CONTRACTOR: License # 5146

Name Same as Above

City/State

Nearest lease or unit boundary line 330 feet.

County Russell

Lease Name KILIAN "B" Well# 1

Domestic well within 330 feet: yes no

Municipal well within one mile: yes no

Well Drilled For: Well Class: Type Equipment:

Oil Swd Infield Mud Rotary

Gas Inj Pool Ext. Air Rotary

OWWO Expl Wildcat Cable

If OWWO: old well info as follows:

Operator

Well Name

Comp Date Old Total Depth

Projected Total Depth 3450 feet

Projected Formation at TD Lansing/Kansas City

Expected Producing Formations Kansas City

Depth to Bottom of fresh water 75 feet

Lowest usable water formation Dakota

Depth to Bottom of usable water 450 feet

Surface pipe by Alternate: 1 2

Surface pipe to be set 260 feet

Conductor pipe if any required -0- feet

Ground surface elevation feet MSL

This Authorization Expires 2-9-85

Approved By 8-9-84 [Signature]

I certify that we will comply with K.S.A. 55-101, et seq., plus eventually plugging hole to K.C.C. specifications.

Date 8-8-84 Signature of Operator or Agent

[Signature] Title PRESIDENT


WILSON RAINS

MHC/UDHE 8/9/84

**Must be filed with the K.C.C. five (5) days prior to commencing well
This card void if drilling not started within six (6) months of date received by K.C.C.**

Important procedures to follow :

**A Regular Section of Land
1 Mile = 5,280 Ft.**

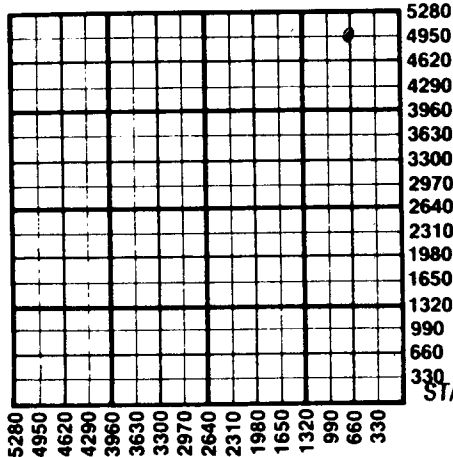

1. Notify District office before setting surface casing.
2. Set surface casing by circulating cement to the top.
3. File completion forms ACO-1 with K.C.C. within 90 days of well completion, following instructions on ACO-1, side 1, and including copies of wireline logs.
4. Notify District office 48 hours prior to old well workover or re-entry.
5. Prior to plugging, prepare a plugging plan, then obtain agreement from the appropriate district office for an approved plugging plan.
6. Submit plugging report (CP-4) to K.C.C. after plugging is completed.
7. Obtain an approved injection docket number before disposing of salt water.
8. Notify K.C.C. within 10 days when injection commences or terminates.

RECEIVED

STATE CORPORATION COMMISSION

or an alternate 2 completion, cement in the production pipe from below any usable water to surface within 120 days of spud date.

AUG 09 1984
08-09-84
CONSERVATION DIVISION
Wichita, Kansas

**State Corporation Commission of Kansas
Conservation Division
200 Colorado Derby Building
Wichita, Kansas 67202
(316) 263-3238**