

15-063-20042-00-00


STATE OF KANSAS
STATE CORPORATION COMMISSION

Form CP-4

Give All Information Completely
Make Required Affidavit
Mail or Deliver Report to:
Conservation Division
State Corporation Commission
212 No. Market
Wichita, Kansas

WELL PLUGGING RECORD

NORTH

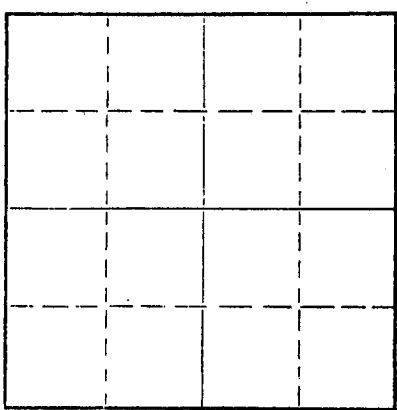

Locate well correctly on above
Section Plat

Gove County, Sec. 3 Twp. 11S Rge. (E) 26 (W)

Location as "NE/CNW/SW" or footage from lines 660' FNL & 560' FEL
Lease Owner: Cities Service Oil Company
Lease Name: Flora "C" Well No. 1
Office Address: 710 Sutton Place, Wichita, Kansas 67202
Character of Well (completed as Oil, Gas or Dry Hole): Dry Hole
Date well completed: October 1, 19 69
Application for plugging filed: 19
Application for plugging approved: 19
Plugging commenced: October 1, 19 69
Plugging completed: October 1, 19 69
Reason for abandonment of well or producing formation: Dry Hole

If a producing well is abandoned, date of last production: 19
Was permission obtained from the Conservation Division or its agents before plugging was commenced? Yes (W. L. Nichols of Moreland)

Name of Conservation Agent who supervised plugging of this well:
Producing formation: Depth to top: Bottom: Total Depth of Well 4630 Feet
Show depth and thickness of all water, oil and gas formations.

OIL, GAS OR WATER RECORDS

CASING RECORD

FORMATION	CONTENT	FROM	TO	SIZE	PUT IN	PULLED OUT
	Surface	0	358'	8-5/8"	358'	None
	Casing					

Describe in detail the manner in which the well was plugged, indicating where the mud fluid was placed and the method or methods used in introducing it into the hole. If cement or other plugs were used, state the character of same and depth placed, from _____ feet to _____ feet for each plug set.

Mud from Total Depth to 1350 Feet,
Plug and 70 sax cement; Mud to
350', Plug and 20 sax cement; Mud
to 40 Feet; 1/2 sax hulls, Plug Bridged
w/Kelly and 10 sax cement to Base
of Cellar; 2 sax cement in rat hole.
Job Completed 3:15 P.M. 10/1/69.

RECEIVED
STATE CORPORATION COMMISSION
OCT 8 1969
CONSERVATION DIVISION
Wichita, Kansas
10-08-1969

(If additional description is necessary, use BACK of this sheet)

Name of Plugging Contractor: Halliburton
Address: Box 339, Hays, Kansas

STATE OF KANSAS, COUNTY OF SEDGWICK, ss.
Wayne W. Kahmeyer of Sage Drilling Co., Inc. (employee of owner) or (owner or operator) of the above-described well, being first duly sworn on oath, says: That I have knowledge of the facts, statements, and matters herein contained and the log of the above-described well as filed and that the same are true and correct. So help me God.

(Signature) Wayne W. Kahmeyer
500 Bitting Building, Wichita, Kansas 67202
(Address)



Subscribed and sworn to before me this 7th day of October, 19 69
November 26, 1970.
Louise K. Whitted
Notary Public.

15-063-20042-00-00

DRILLERS LOG

FLORA "C" NO. 1

CASING RECORD:	OPERATOR:	Cities Service Oil Co.	DESCRIPTION:
8-5/8" 358' w/275 sax cement	CONTRACTOR:	Sage Drilling Co., Inc.	660' FNL & 560' FEL Sec. 3-11S-26W Gove County, Kansas
TOTAL DEPTH:	COMMENCED:	September 19, 1969	ELEVATION: 2521 KB
4630'	COMPLETED:	October 1, 1969	

<u>FORMATION</u>	<u>FROM</u>	<u>TO</u>	<u>REMARKS</u>
Surface Soil	0	325	
Shale	325	2135	
Anhydrite	2135	2165	
Shale & Lime	2165	2660	
Lime & Shale	2660	3085	
Shale & Lime	3085	3625	
Lime & Shale	3625	3816	
Lime	3816	3900	
Lime & Chert	3900	4215	
Lime	4215	4385	
Lime & Chert	4385	4630	

RECEIVED
STATE CORPORATION COMMISSION
OCT 8 1969
CONSERVATION DIVISION
Wichita, Kansas
10-08-1969
D&A

I certify that this is a true and correct copy of the above log to the best of my knowledge.

SAGE DRILLING CO., INC.

By Wayne W. Kahmeyer
Wayne W. Kahmeyer



Subscribed and sworn to before me this 3rd day of October, 1969.

Louise K. Whitted
Louise K. Whitted, Notary Public

My commission expires:
November 26, 1970.

15-063-2004200-00
WELL RECORD

Company Citizen Service Oil Company Well No. 1 Farm Flora "C"
 Location 660' FKL 360' FKL Sec. 3 T. 11S R. 26W
 Elevation 2516' GL County Cove State Kansas
 Initial Prod. Dry and abandoned 10-1-69 Contractor Eagle Drilling Company
 Acid None Drlg. Comm. 9-19-69
 T. D. 4630' Drlg. Comp. 10-1-69

Casing Record:

8 5/8" @ 357' 4/275 Gr. Formix Plus 2% CaCl

Formation Record:

Formation	Depth
Foot Rock & Clay	0- 70'
Shale & Sand	70- 160'
Shale	160- 365'
Shale & Shells	365- 965'
Sand & Shale	965-1118'
Sand	1118-1220'
Shale	1220-2135'
Anhydrite	2135-2165'
Shale & Lime	2165-3726'
Lime	3726-4025'
Lime & Shale	4025-4315'
Lime, Shale & Chert	4315-4385'
Lime & Chert	4385-4630'

Electric Log Test:

Topoka	3599 (-1078)
Heebner	3781 (-1260)
Toronto	3802 (-1281)
Lansing-Kansas City	3820 (-1299)
Base L-KC	4040 (-1519)
Harmon	4052 (-1531)
Fort Scott	4282 (-1761)
Mississippi	4382 (-1861)
Gilmore City	4438 (-1937)
Rinderhook	4559 (-2038)
Viola	4563 (-2042)
Arbuckle	4606 (-2083)

Completion Data:

Plugged and Abandoned 10-1-69

Flow Test:

Flow Rate

365'	0°
1900'	1 1/2°
2460'	3/4°
2800'	3/4°
3139'	1/2°

RECEIVED
 STATE CORPORATION COMMISSION
 OCT 9 1969
 CONSERVATION DIVISION
 Wichita, Kansas
 10-09-1969