


WELL PLUGGING RECORD

Give All Information Completely
Make Required Affidavit
Mail or Deliver Report to:
Conservation Division
State Corporation Commission
211 No. Broadway
Wichita, Kansas

NORTH

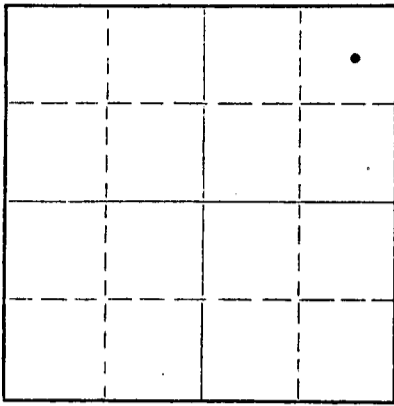

Locate well correctly on above Section Plat

Gove County, Sec. 12 Twp. 11S Rge. 26 (X) W (W)
Location as "NE/CNW&SW¼" or footage from lines NE-NE-NE
Lease Owner Amerada Petroleum Corporation
Lease Name H. Yanda Well No. 1
Office Address Box 197, Great Bend, Kansas
Character of Well (completed as Oil, Gas or Dry Hole) Dry Hole
Date well completed November 5, 1958
Application for plugging filed November 5, 1958
Application for plugging approved November 5, 1958
Plugging commenced November 5, 1958
Plugging completed November 5, 1958
Reason for abandonment of well or producing formation Dry Hole

If a producing well is abandoned, date of last production - 19 -
Was permission obtained from the Conservation Division or its agents before plugging was commenced? Yes

Name of Conservation Agent who supervised plugging of this well Gilbert Leicker
Producing formation - Depth to top - Bottom - Total Depth of Well 4473' Feet
Show depth and thickness of all water, oil and gas formations.

OIL, GAS OR WATER RECORDS

CASING RECORD

| FORMATION | CONTENT | FROM | TO | SIZE | PUT IN | PULLED OUT |
|-----------|---------|------|------|--------|--------|------------|
| | | 0' | 265' | 8-5/8" | 262' | None |
| | | | | | | |
| | | | | | | |
| | | | | | | |
| | | | | | | |
| | | | | | | |
| | | | | | | |
| | | | | | | |

Describe in detail the manner in which the well was plugged, indicating where the mud fluid was placed and the method or methods used in introducing it into the hole. If cement or other plugs were used, state the character of same and depth placed, from _____ feet to _____ feet for each plug set.

4473' to 540' Filled Hole with Heavy Rotary Mud
540' to 477' Spotted Plug W/1/2 Sack Hulls & 20 Sacks Cement
477' to 240' Filled Hole With Heavy Rotary Mud
240' to 192' Spotted Plug W/1/2 Sack Hulls & 15 Sacks Cement
192' to 40' Filled hole with Heavy Rotary Mud
40' to 0' Spotted Plug W/1/2 Sack Hulls & 10 Sacks Cement

NOV 12 1958
11-12-58
CONSERVATION DIVISION
Wichita, Kansas

(If additional description is necessary, use BACK of this sheet)
Name of Plugging Contractor Peel Brothers Inc.
Address P.O. Box 359, Hoisington, Kansas

STATE OF Kansas, COUNTY OF Barton, ss.
Ernest Higgins (employee of owner) or (owner or operator) of the above-described

well, being first duly sworn on oath, says: That I have knowledge of the facts, statements, and matters herein contained and the log of the above-described well as filed and that the same are true and correct. So help me God.

(Signature) Ernest Higgins
P.O. Box 197, Great Bend, Kansas (Address)

SUBSCRIBED AND SWORN TO before me this 11th day of November, 19 58

My commission expires November 21, 1961
Charles W. Ambrose Notary Public.



PLUGGING
FILE SEC. 12 T. 11 R. 26 W
BOOK PAGE 144 LINE 18

15-063-19006-00-00

DRILLERS' LOG

Well Owner: Amerada Petroleum Corporation NE NE NE
 Farm Name: H. Yanda No. 1 Sec. 12, Twp. 11S, Rge. 26W,
 Commenced: 10/24/58 Gove County,
 Completed: 11/5/58 Kansas
 Total Depth: 4473' Elevation:
 Casing: 8 5/8" @ 251' cemented Production: Dry
 Contractor: Peel Brothers, Inc.

Figures below indicate bottoms of formations:

| | | |
|-----------------------|-----|------|
| Rock | 0 - | 60 |
| Shale and shells | | 810 |
| Shale | | 1100 |
| Sand | | 1440 |
| Shale | | 1500 |
| Shale and shells | | 2110 |
| Anhydrite | | 2175 |
| Shale and shells | | 2185 |
| Red bed and shale | | 2485 |
| Shale and shells | | 2525 |
| Lime and shale | | 2755 |
| Lime | | 2885 |
| Lime and shale | | 3855 |
| Lime | | 4070 |
| Lime and shale | | 4250 |
| Lime | | 4295 |
| Lime and shale | | 4404 |
| Lime, shale and chert | | 4435 |
| Lime and chert | | 4473 |
| Total Depth | | 4473 |

This is to certify that the above information is to the best of our knowledge, true and correct.

PEEL BROTHERS, INC.

BY: *Handell G. Peel*

SUBSCRIBED AND SWORN to before me this 10th day of November, 1958

My commission expires: April 27, 1960

Luth Brack
Notary Public

NOV 12 1958

PLUGGING
 FILE SEC. 12 T. 11 R. 26W
 BOOK PAGE 144 LINE 18