


STATE OF KANSAS
STATE CORPORATION COMMISSION

Give All Information Completely
Make Required Affidavit
Mail or Deliver Report to:
Conservation Division
State Corporation Commission
800 Bitting Building
Wichita, Kansas

15-063-00023-00-00

WELL PLUGGING RECORD

NORTH

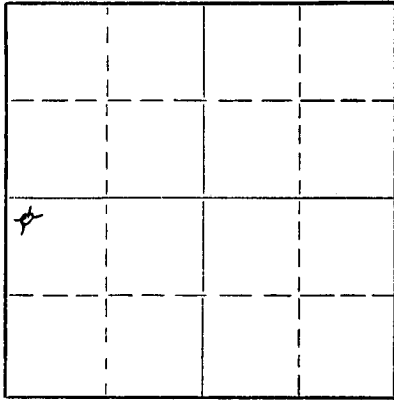

Locate well correctly on above
Section Plat

Gove County, Sec 27 Twp 11 Rge. 26 (E) (W) W
Location as "NE/CNW/SW" or footage from lines C NW NW SW
Lease Owner Virginia Drlg Co Inc
Lease Name Neher Well No. 1
Office Address 701 Brown Bldg., Wichita 2, Kansas
Character of Well (completed as Oil, Gas or Dry Hole) Dry hole
Date well completed 3-25-54 19
Application for plugging filed 3-25-54 19
Application for plugging approved 3-25-54 19
Plugging commenced 3-25-54 19
Plugging completed 3-25-54 19
Reason for abandonment of well or producing formation

If a producing well is abandoned, date of last production 19
Was permission obtained from the Conservation Division or its agents before plugging was commenced? yes

Name of Conservation Agent who supervised plugging of this well Eldon Petty
Producing formation Depth to top Bottom Total Depth of Well 4761 Feet
Show depth and thickness of all water, oil and gas formations.

OIL, GAS OR WATER RECORDS

CASING RECORD

FORMATION	CONTENT	FROM	TO	SIZE	PUT IN	PULLED OUT
		0	235	8 5/8"	237.18	none

Describe in detail the manner in which the well was plugged, indicating where the mud fluid was placed and the method or methods used in introducing it into the hole. If cement or other plugs were used, state the character of same and depth placed, from feet to feet for each plug set.

Mudded hole to 220 feet - set plug w/15 sx cement
Mudded hole to 40 ft. - set plug with 10 sx cement

03 31-1954

(If additional description is necessary, use BACK of this sheet)

Name of Plugging Contractor Virginia Drlg Co Inc
Address 701 Brown Bldg., Wichita 2, Kansas

STATE OF Kansas, COUNTY OF Sedgwick, ss.
S. A. Murphy

(employee of owner) or (owner or operator) of the above-described well, being first duly sworn on oath, says: That I have knowledge of the facts, statements, and matters herein contained and the log of the above-described well as filed and that the same are true and correct. So help me God.

(Signature) *S. A. Murphy*
701 Brown Bldg., Wichita 2, Kansas
(Address)

SUBSCRIBED AND SWORN TO before me this 30th day of March, 1954

My commission expires Febr. 5, 1957.

24-2675-S 2-52-20M

PLUGGING
FILE SEC-27 T-11 R-26W
BOOK PAGE 23 LINE 16

Notary Public.

15-063-00023-00-00

Meher # 1 - C NW NW SW/4 Section 27-11-26 Gove County, Kansas
Company - Virginia Drilling Co., Inc.

Contractor - same

Commenced - March 10, 1954

Completed - March 25, 1954

8 5/8 " set at 235 ft.

Elevation - 2652 DF

Total Depth - 4761

FORMATION	DEPTH
Shale-shell	0-145
Sand	145-155
Shale-shell	155-235
Shale	235-625
Shale-shell	625-1100
Sand	1100-1135
Shale	1135-1325
Shale-shells	1325-1450
Shale	1450-1650
Shale-shells	1650-2255
Anhydrite	2255-2295
Shale-shells	2295-2535
Shale-lime	2535-2735
Shale-shells	2735-2880
Lime-shale	2880-3105
Shale-shells	3105-3275
Shale-lime	3275-3365
Shale	3365-3445
Shale-shells	3445-3610
Shale-lime	3610-3830
Lime	3830-4194
Lime-shale	4194-4465
Shale	4465-4533
Mississippi lime	4533-4590
Lime	4590-4745
Lime Cherty	4745-4761 TD

TOPS:

- 3891 - Heebner
- 3927 - Lansing KC
- 4178 - Base KC
- 4533 - Mississippi lime
- 4657 - Viola
- 4735 - Arbuckle

S. A. Murphy

 S. A. Murphy

Subscribed and sworn to before me, a Notary Public, this 30th day of March 1954.

Marlee Hawkins

 Notary Public

My commission expires: Febr. 5, 1957.

PLUGGING
 FILE SEC 22T 11 R 26W
 BOOK PAGE 23 LINE 16

C3-31-1954