


WELL PLUGGING RECORD

Give All Information Completely
Make Required Affidavit
Mail or Deliver Report to:
Conservation Division
State Corporation Commission
211 No. Broadway
Wichita, Kansas

NORTH

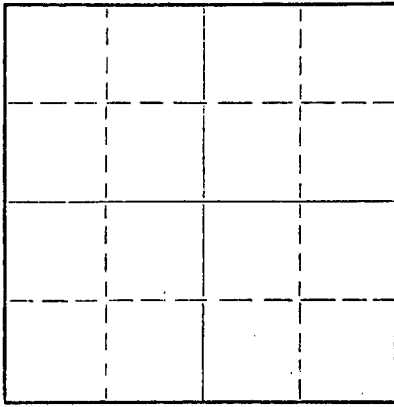

Locate well correctly on above
Section Plat

Gove County. Sec. 36 Twp. 11S Rge. 26W (E) (W)

Location as "NE/CNW/SW" or footage from lines NE NE NW

Lease Owner Imperial Oil of Kansas, Inc.

Lease Name Long Well No. 1

Office Address Wichita, Kansas

Character of Well (completed as Oil, Gas or Dry Hole) Dry Hole

Date well completed September 6, 1956

Application for plugging filed September 6, 1956

Application for plugging approved September 6, 1956

Plugging commenced September 6, 1956

Plugging completed September 6, 1956

Reason for abandonment of well or producing formation No oil in commercial quantities found.

If a producing well is abandoned, date of last production 19

Was permission obtained from the Conservation Division or its agents before plugging was commenced? Yes

Name of Conservation Agent who supervised plugging of this well _____

Producing formation _____ Depth to top _____ Bottom _____ Total Depth of Well 4737 Feet

Show depth and thickness of all water, oil and gas formations.

OIL, GAS OR WATER RECORDS

CASING RECORD

FORMATION	CONTENT	FROM	TO	SIZE	PUT IN	PULLED OUT
				8-5/8"	9-6-56	

Describe in detail the manner in which the well was plugged, indicating where the mud fluid was placed and the method or methods used in introducing it into the hole. If cement or other plugs were used, state the character of same and depth placed, from _____ feet to _____ feet for each plug set.

Set bottom plug at 300 feet with
15 sacks cement. Set top plug
at 40 feet with 10 sacks cement.

09-14-1956
CONSERVATION DIVISION
WICHITA, KANSAS

(If additional description is necessary, use BACK of this sheet)

Name of Plugging Contractor Imperial Oil of Kansas, Inc.

Address 903 Union National Bank Building, Wichita, Kansas

STATE OF Kansas, COUNTY OF Sedgwick, ss.

Raymond L. Bacon (employee of owner) or (owner or operator) of the above-described

well, being first duly sworn on oath, says: That I have knowledge of the facts, statements, and matters herein contained and the log of the above-described well as filed and that the same are true and correct. So help me God.

(Signature) By: Raymond L. Bacon IMPERIAL OIL OF KANSAS, INC. V-P

903 Union National Bank Bldg. Wichita, Ks.

(Address)

SUBSCRIBED AND SWORN TO before me this 12th day of September, 19 56

Frances E. Barham
Frances E. Barham Notary Public.

My commission expires April 18, 1959

PLUGGING
FILE SEC 36T 11 R 26W
BOOK PAGE 97 LINE 28

15-063-60021-00-00

DRILLER'S LOG

Imperial Oil of Kansas, Inc.
903 Union National Bank Building
Wichita, Kansas

Long No. 1
NE NE NW Sec. 36-11S-26W
Gove County, Kansas

Total Depth: 4737'

Commenced: 8-21-56 Completed: 9-6-56 Elevation: 2614' R.B.
Production: D & A

Contractor: Imperial Oil of Kansas, Inc.
Wichita, Kansas

Casing Record: Set 8-5/8" Surface Pipe at 326' with 225 sacks cement.

Figures indicate bottom of formations:

Sand, Shale and Shells	2174'		
Anhydrite	2228'		
Shale and Shells	2630'	Anhydrite	<u>TOPS</u> 2174' (440)
Shale and Lime	3500'	Heebner	3876' (-1262)
Lime	3618'	Lansing	3912' (-1298)
Shale and Lime	4030'	Conglomerate	4469' (-1855)
Lime	4230'	Mississippi	4496' (-1882)
Lime and Shale	4470'	Viola	4633' (-2019)
Lime and Chert	4680'	Arbuckle	4702' (-2088)
Lime	4737'	Total Depth	4737' (-2123)
Total Depth	4737'		

We hereby certify this to be a correct and accurate log of the above described well as shown on the daily drilling reports.

IMPERIAL OIL OF KANSAS, INC.

By: Walter P. G. Gauer
Vice-President

Subscribed and sworn to before me this 12th day of September, 1956.

My Commission Expires:

April 18, 1959

Frances E. Dusham
Notary Public

PLUGGING
 FILE SEC. 36 T. 11 R. 26W
 BOOK PAGE 97 LINE 28

SEP 14 1956
CONSERVATION DIVISION
Wichita, Kansas

09-14-1956