

STATE OF KANSAS
STATE CORPORATION COMMISSION


WELL PLUGGING RECORD

Give All Information Completely
Make Required Affidavit
Mail or Deliver Report to:
Conservation Division
State Corporation Commission
800 Bitting Building
Wichita, Kansas

OR
FORMATION PLUGGING RECORD

Strike out upper line
when reporting plug-
ging off formations.

Russell County Sec. 26 Twp. 12 Rge. 14 (W) --- (W)
Location as "NE 1/4 NW 1/4 SW 1/4" or footage from lines NE 1/4 of NE 1/4 of NW 1/4
Lease Owner G. W. Davis
Lease Name Mary H. Funk Well No. 1
Office Address Russell, Kansas
Character of Well (completed as Oil, Gas or Dry Hole) Dry Hole
Date well completed Oct. 6 1943
Application for plugging filed Oct. 6 1943
Application for plugging approved 19
Plugging commenced Oct. 8 1943
Plugging completed Oct. 10 1943
Reason for abandonment of well or producing formation Dry Hole

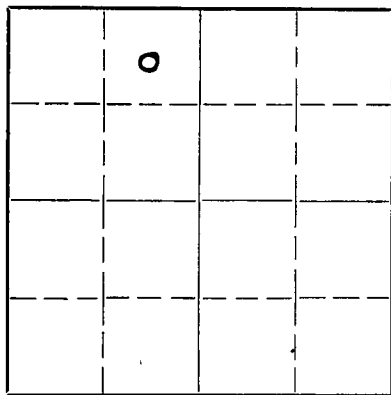

Locate well correctly on above
Section Plat

If a producing well is abandoned, date of last production 19
Was permission obtained from the Conservation Division or its agents before plugging was com-
menced? Yes

Name of Conservation Agent who supervised plugging of this well A. T. Alexander
Producing formation Depth to top Bottom Total Depth of Well 3393 Feet
Show depth and thickness of all water, oil and gas formations.

OIL, GAS OR WATER RECORDS

CASING RECORD


Formation	Content	From	To	Size	Put In	Pulled Out
	Water	250	270	15 1/2	318-6	318-6
	"	340	350	12 1/2	546	546
	"	670	675	10	816	816
	"	720	730	8	2410	2410
	"	3346	3352	7	2962	2962
	"	3387	3393	5-3/16	3224	3224

Describe in detail the manner in which the well was plugged, indicating where the mud fluid was placed and the method or methods used in introducing it into the hole. If cement or other plugs were used, state the character of same and depth placed, from feet to feet for each plug set.

Cemented 3393 to 3363 ft. 30 ft.
Mud 3363 " 275 " 3088 "
Cemented 275 " 255 " 20 "
Mud & bridge 255 " 20 " 235 "
Cement 20 " 5 " 15 "

Regular cement bailer used to lower cement to given levels
Mud dumped in hole with bailer and mud bucket.

26 12 14W
93 42

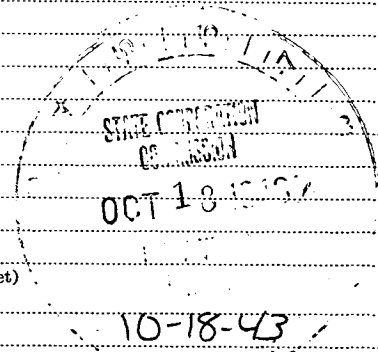

(If additional description is necessary, use BACK of this sheet)

Correspondence regarding this well should be addressed to O. G. Stearns
Address Russell, Kansas.

STATE OF Kansas COUNTY OF Russell, ss.
O. G. Stearns, Supt. Stearns Drilling Co (employee of owner) or (owner or operator) of the above-described well,
being first duly sworn on oath, says: That I have knowledge of the facts, statements, and matters herein contained and the log of the above-
described well as filed and that the same are true and correct. So help me God.

(Signature) [Signature] Supt

(Address)

SUBSCRIBED AND SWORN TO before me this 11th day of October, 1943

My commission expires Aug 17 - 1946 [Signature] Notary Public.



FORMATION	From	To	Feet	FORMATION	From	To	Feet
Cellar		15		Lime	2310	2340	
Sand	15	25		Shale blue	2340	2405	
Shale blue	25	175		Lime	2405	2409	
Shale brown	175	200		Ran 2410' 8" casing			
Shale grey	200	225		SIM 2409 equqls 2416			
Shale blue	225	250		Lime	2416	2430	
Sand HFW 250-270	250	270		Shale blue	2430	2435	
Shale blue	270	290		Shale blue	2435	2475	
Red Rock	290	295		Lime	2475	2480	
Shale blue	295	310		Lime (Caving)	2480	2520	
Shale red	310	325		Lime	2520	2525	
Shale blue	325	340		Shale blue	2525	2530	
Sand HFW 340-350	340	350		Lime	2530	2548	
Shale blue	350	355		Shale sandy	2548	2610	
Shale red	355	370		Shale blue	2610	2615	
Shale blue	370	400		Lime	2615	2620	
Sand	400	415		Shale blue	2620	2623	
Shale blue	415	490		Lime	2623	2638	
Shale grey	490	500		Shale blue	2638	2643	
Shale blue	500	512		Lime	2643	2655	
Shale red	512	522		Lime (Caving)	2655	2667	
Red rock 2BWPH 670-675	522	815		Shale blue (Caving)	2667	2677	
Water 720-730				Lime soft	2677	2687	
Anhydrite	815	820		Ran 2685' 7" casing			
Lime	820	850		Shale blue	2687	2705	
Shale red	850	855		Lime	2705	2775	
Red rock	855	975		Shale black	2775	2780	
Shale grey	975	1020		Lime	2780	2917	
Shale red	1020	1055		Shale blue	2917	2927	
Red rock	1055	1060		Lime	2927	2943	
Shale blue	1060	1075		Lime Dodge	2943	2946	
Shale grey	1075	1090		Shale blue	2946	2950	
Shale brown	1090	1103		Shale red	2950	2955	
Shale grey	1103	1125		Shale	2955	2960	
Salt	1125	1135		Lime Kansas City	2960	2980	
Salt broken	1135	1160		Underreamed and set			
Salt	1160	1435		7" casing to 2962			
Shale blue	1435	1450		Shale blue	2980	2989	
Salt broken	1450	1465		Lime	2989	3032	
Shale blue	1465	1470		Shale	3032	3036	
Lime broken	1470	1500		Lime	3036	3173	
Lime	1500	1510		Shale black	3173	3175	
Shale blue	1510	1515		Shale green	3175	3179	
Lime	1515	1530		Lime	3179	3200	
Shale blue	1530	1540		Shale	3200	3206	
Shale and Shells	1540	1555		Lime	3214	3233	
Lime	1555	1577		Ran 3224 ' of 5-3/16"			
Red Rock	1577	1600		casing			
Lime	1600	1628		Shale blue	3233	3237	
Shale blue	1628	1633		Lime	3237	3246	
Shale red	1633	1640		Shale - red rock	3246	3250	
Shale green	1640	1645		Lime	3250	3267	
Lime	1645	1740		Shale blue	3267	3271	
Shale blue	1740	1745		Lime	3271	3277	
Lime	1745	1830		Conglomerate	3277	3290	
Shale blue	1830	1840		Conglomerate	3290	3336	
Red Rock	1840	1850		Lime	3336	3393	
Lime	1850	1908		2BWPH 3346 to 3352			
Shale blue	1908	1922		Water 3387 to 3393			
Lime	1922	2022					
Shale red	2022	2042					
Lime	2042	2100					
Shale blue	2100	2115		Total Depth 3393			
Lime	2115	2135					
Shale and shells	2135	2150		Surface Elev. 1776			
Shale	2150	2155					
Lime hard	2155	2180					
Lime	2180	2200		Dry Hole			
Shale blue	2200	2215					
Lime	2215	2235					
Shale blue	2235	2250					
Lime	2250	2256					
Shale blue	2256	2270					
Lime	2270	2280					
Shale blue	2280	2285					
Lime	2285	2292					
Shale and Shells	2292	2310					