

WELL PLUGGING RECORD

STATE OF KANSAS
STATE CORPORATION COMMISSION


Give All Information Completely
Make Required Affidavit
Mail or Deliver Report to:
Conservation Division
State Corporation Commission
800 Bitting Building
Wichita, Kansas

OR

FORMATION PLUGGING RECORD

Strike out upper line
when reporting plug-
ging off formations.

NORTH

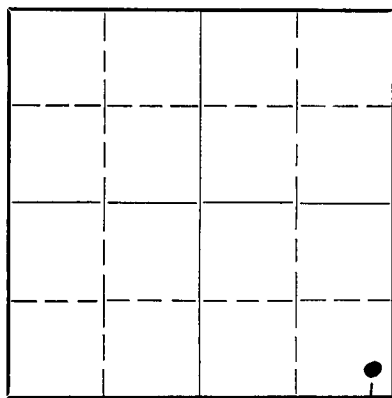

Locate well correctly on above
Section Plat

Russell County. Sec. 27 Twp. 12S Rge. 14 (E) (W) X
Location as "NE 1/4 NW 1/4 SW 1/4" or footage from lines SE SE SE 1/4
Lease Owner Geough W. Davis
Lease Name Claussen Well No. 1
Office Address Russell, Kansas
Character of Well (completed as Oil, Gas or Dry Hole) Dry Hole
Date well completed June 29 19 43
Application for plugging filed July 1 19 43
Application for plugging approved July 1 19 43
Plugging commenced July 1 19 43
Plugging completed July 2 19 43
Reason for abandonment of well or producing formation Dry Hole

If a producing well is abandoned, date of last production 19...
Was permission obtained from the Conservation Division or its agents before plugging was com-
menced?.....

Name of Conservation Agent who supervised plugging of this well Bert Stafford
Producing formation..... Depth to top..... Bottom..... Total Depth of Well 3117 Feet
Show depth and thickness of all water, oil and gas formations.

OIL, GAS OR WATER RECORDS


CASING RECORD

Formation	Content	From	To	Size	Put In	Pulled Out
	Water	110	120			
	"	170	180	15	216	216
	"	195	205	12	377	377
	"	216	225	10	647	647
	"	260		8	2253	2253
	"	490	500	7	2792	2792
	"	2460	2465			
	"	2580	2590			
	2885	2885	2895			
	"	2885	3117			

Describe in detail the manner in which the well was plugged, indicating where the mud fluid was placed and the method or methods used in introducing it into the hold. If cement or other plugs were used, state the character of same and depth placed, from.....feet to.....feet for each plug set.

Cemented 15 sacks cement 3117 to 3035 ft
Mud 3035 2780 "
Cemented 15 " " 2780 2700 "
Mud 2700 600 "
Cement on bridge 30 " " 600 550 "
Mud 550 80 "
Cement & Rock on bridge 25 sacks cement 80 10 "

Regular cement bailer used to lower cement to given levels
Mud dumped in hole with bailer and mud bucket

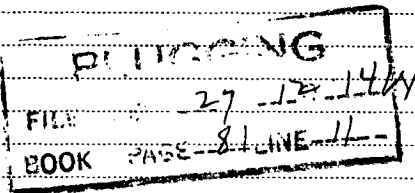

07-09-43

(If additional description is necessary, use BACK of this sheet)

Correspondence regarding this well should be addressed to O. G. Stearns
Address Russell, Kansas.

STATE OF Kansas, COUNTY OF Russell, ss.
O. G. Stearns, Supt, Stearns Drilling Co (employee of owner) or (owner or operator) of the above-described well,
being first duly sworn on oath, says: That I have knowledge of the facts, statements, and matters herein contained and the log of the above-
described well as filed and that the same are true and correct. So help me God.

(Signature) [Signature]

Russell, Kansas
(Address)

SUBSCRIBED AND SWORN to before me this 3rd day of July, 19 43

My commission expires August 17-1946

[Signature] Notary Public.



WELL RECORD AND LOG

Well No. 1 Claussen Farm

Location SE SE SE 1/4 Sec. 27 Twp. 12 S Range 14 W County Russell Kansas

Rig Commenced		19	} <u>Keith Rig Co</u>	Contractor
Rig Completed	May 28	19 43		
Drilling Commenced	May 28	19 43	} <u>Stearns Drilling Co</u>	Contractor
Drilling Completed	June 29	19 43		

CASING AND TUBING

SIZE	Weight Per Foot	Put in Well		Pulled Out of Well		Left in Well		REMARKS
		FEET	INCHES	FEET	INCHES	FEET	INCHES	
		15 1/2		216				
12		377						
10		647						
8		2253						
7		2792						

SAND RECORD

NAME	TOP	TOP	FEET of SAND	REMARKS

PLUGGING
 FILE SEC 27-12-RL44
 BOOK PAGE 8-LINE-11

TOTAL DEPTH 3117 ft.

SHOT 19 BY SHOOTER

SIZE OF SHOT SAND SHOT

PRODUCTION FIRST 24 HOURS Dry Hole GRAVITY

FORMATION	From	To	Feet	FORMATION	From	To	Feet
Cellar		10		Shale & Shells	1975	2000	
Sand soil	10	25		Blue Shale	2000	2010	
Sand rock	25	40		Lime	2010	2020	
Sand	40	45		Blue Shale	2020	2030	
Lime Shale	45	50		Lime	2030	2050	
Red Rock	50	55		Gray Shale	2050	2060	
Blue Shale	55	110		Lime	2060	2065	
Sand	110	120		Blue Shale	2065	2095	
5 BW				Lime	2095	2105	
Red Rock	120	160		Blue Shale	2105	2115	
Gray Shale	160	170		Lime	2115	2120	
Red Rock	170	180		Lime & Shells & Shale	2120	2135	
Lime	180	185		Blue Shale	2135	2145	
Blue Shale	185	195		Red Rock	2145	2150	
Sand HFW	195	205		Gray Shale	2150	2160	
Blue Shale	205	216		Lime	2160	2170	
Sand	216	225		Blue Shale	2170	2252	
Blue Shale	225	260		Hole caving			
Sand HFW	260	280		Lime	2252	2270	
Blue Shale	280	315		Blue Shale	2270	2300	
Sand	315	320		Lime	2300	2310	
Black Shale	320	325		Shale	2310	2315	
Shale & Lime	325	345		Lime	2315	2365	
Blue Shale	345	365		Blue Shale	2365	2375	
Red Rock 2 BW 490-500	365	641		Lime	2375	2395	
Lime Anhydrite	641	680		Blue Shale	2395	2445	
Red Rock	680	820		Lime	2445	2498	
Blue Shale	820	850		Shale	2498	2510	
Red Rock	850	895		Lime	2510	2515	
Blue Shale	895	950		Show of oil 2510-15			
Brown Shale	950	960		Lime	2515	2610	
Gray Shale	960	970		Water at 2580-90			
Salt	970	980		Lime	2610	2742	
Salt broken	980	1010		Shale	2742	2750	
Salt	1010	1270		Lime Dodge	2750	2767	
Blue Shale	1270	1285		Blue Shale	2767	2770	
Salt	1285	1305		Red Shale	2770	2775	
Blue Shale	1305	1310		Lime	2775	2777	
Lime	1310	1330		Green Shale	2777	2783	
Lime broken	1330	1350		Lime broken	2783	2788	
Blue Shale	1350	1365		Lime hard	2788	2800	
Lime	1365	1385		Gray Shale	2800	2802	
Blue Shale	1385	1395		Lime	2802	2805	
Lime	1395	1405		Blue Shale	2805	2810	
Blue Shale	1405	1415		Lime	2810	2827	
Red Rock	1415	1420		Shale red	2827	2830	
Lime	1420	1430		Shale blue	2830	2835	
Blue Shale	1430	1435		Lime hard	2835	2840	
Lime	1435	1445		Lime	2840	2853	
Blue Shale	1445	1450		Blue Shale	2853	2856	
Lime	1450	1460		Lime	2856	2859	
Blue Shale	1460	1485		Lime broken	2859	2865	
Lime broken	1485	1490		Lime	2865	2885	
Lime hard	1490	1510		Lime broken	2885	2895	
Lime	1510	1520		Lime	2895	2932	
Red Rock	1520	1535		Blue Shale	2932	2935	
Blue Shale	1535	1545		Lime	2935	3000	
Lime	1545	1585		Blue Shale	3000	3010	
Red Shale	1585	1590		Lime	3010	3030	
Lime	1590	1660		Black Shale	3030	3035	
Blue Shale	1660	1670		Lime	3035	3053	
Red Rock	1670	1675		Gray Shale	3053	3060	
Lime	1675	1690		Red & Brown Shale	3060	3065	
Shale & Lime	1690	1700		Lime	3065	3074	
Lime	1700	1750		Red Rock	3074	3078	
Blue Shale	1750	1765		Marmaton Shale	3078	3093	
Lime	1765	1815		Colite Shert	3093	3117	
Blue Shale	1815	1825		Arbuckle Dolomite - 1943	3117	3117	
Lime	1825	1840					
Lime broken	1840	1850					
Lime hard	1850	1870					
Red Rock	1870	1890					
Lime	1890	1935					
Red Rock	1935	1950					
Lime	1950	1970					
Blue Shale	1970	1975					

Total Depth 1621 ft.
 Surface Elevation 1621 ft.