


STATE OF KANSAS
STATE CORPORATION COMMISSION

Give All Information Completely
Make Required Affidavit
Mail or Deliver Report to:
Conservation Division
State Corporation Commission
800 Bitting Building
Wichita, Kansas

WELL PLUGGING RECORD

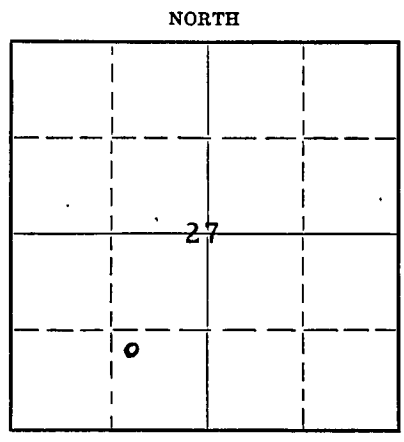

Russell County, Sec. 27 Twp. 12s. Rge. 14 (W)
Location as "NE/CNW $\frac{1}{4}$ SW $\frac{1}{4}$ " or footage from lines NW SE SW
Lease Owner Claussen Brothers
Lease Name Claussen Well No. 5
Office Address Russell, Kansas
Character of Well (completed as Oil, Gas or Dry Hole) Dry Hole
Date well completed February 21, 19 53
Application for plugging filed March 4, 19 53
Application for plugging approved 19
Plugging commenced February 20, 1953 19
Plugging completed February 20, 1953 19
Reason for abandonment of well or producing formation Dry Hole
If a producing well is abandoned, date of last production None 19
Was permission obtained from the Conservation Division or its agents before plugging was commenced? yes

Name of Conservation Agent who supervised plugging of this well Hollis
Producing formation Lansing Depth to top 2954 Bottom 3068 Total Depth of Well 3068 Feet
Show depth and thickness of all water, oil and gas formations.

OIL, GAS OR WATER RECORDS

CASING RECORD

Formation	Content	From	To	Size	Put In	Pulled Out
Dakota Sand	HFV	335	350	12 1/2"	490	490
Anhydrite Lime	O	813	850	10 3/4"	821	821
Topeka Lime	O	2677	2902	8 5/8"	2393	2393
Heebner Shale	O	2902	2905	7"	2955	2955
Lansing Lime	O	2954	3068			

Describe in detail the manner in which the well was plugged, indicating where the mud fluid was placed and the method or methods used in introducing it into the hole. If cement or other plugs were used, state the character of same and depth placed, from _____ feet to _____ feet for each plug set.

3 sacks cement @ T.D. 3068'
Mudded to 200'
25 sacks cement @ 200'
Mudded to 35'
Set Rock Bridge @ 35'
15 sacks cement 35' to bottom of cellar.
Mud and filled cellar to surface.

03-09-53
CON DIVISION
KANTZO

(If additional description is necessary, use BACK of this sheet)
Name of Plugging Contractor Shields Oil Producers
Address Box 248
Russell, Kansas

STATE OF _____, COUNTY OF _____, ss.
_____ (employee of owner) or (owner or operator) of the above-described well,
being first duly sworn on oath, says: That I have knowledge of the facts, statements, and matters herein contained and the log of the above-described well as filed and that the same are true and correct. So help me God.

(Signature) Fred Claussen
Rural Route 3 - Russell, Kansas
(Address)

SUBSCRIBED AND SWORN to before me this 7th day of March, 19 53

Jo Anne Logsdon
Notary Public.

My commission expires May 28 - 1955

PLUGGING
FILE SEC 27 T 12 R 14
BOOK PAGE 81 LINE 25

WELL LOG

Claussen Oil Producers
Claussen #5

NW SE SW
Sec. 27, Twp. 12, Rge. 14w
Russell County, Kansas

T.D. - 3068'
Commenced - January 16, 1953
Completed - February 21, 1953
Drilled with Shields Cable Tools

CASING RECORD

Size	Run	Pulled
12 1/2"	490'	Pulled
10"	821	Pulled
8"	2393'	Pulled
7"	2955'	Pulled

Elevation: 1785'
Treatment: None
Production: Dry & Abandoned

----- - Figures Indicate Bottom of Formation - -----

Cellar	9	Lime - Broken	1665
Post Rock	28	Lime	1690
Black Slate	50	Redrock	1715
Blue Slate	105	Lime	1750
Black Slate	115	Slate	1758
Blue Slate	140	Lime	1819
Sandy Shale	160	Lime, Hard, Sharp	1839
Dry Sand	195	Slate	1848
Gray Slate	205	Redrock	1860
Black Slate	250	Lime	1872
Sand	15 BW 262	Slate	1875
Slate	270	Lime	1880
Sandy Shale	295	Slate	1890
Redrock	315	Lime	1910
Gray Slate	335	Lime - Sharp	1917
Sand	HFW 350	Slate	1932
Slate	378	Lime - Broken	1975
Sand	385	Lime	1988
Slate	400	Redrock	1995
Sand	410	Lime	2005
Slate	420	Slate	2012
Hard Sand - sharp	428	Lime - Hard	2037
Sandy Shale	440	Redrock CAVE	2052
Sandy Shale	520	Lime	2115
Redrock	810	Slate	2120
Chalk	813	Redrock	2130
Anhydrite Lime	850	Lime	2145
Redrock	980	Slate	2155
Blue Slate	1030	Lime	2190
Redrock	1100	Slate	2195
Blue Slate	1208	Lime	2200
Salt	1215	Slate	2210
Slate	1222	Lime	2230
Salt	1450	Slate	2255
Slate	1460	Lime	2265
Lime - Broken	1511	Slate CAVE	2290
Lime	1515	Lime - Broken	2320
Slate	1520	Lime	2325
Lime	1535	Slate	2338
Slate	1550	Lime	2352
Lime	1560	Slate	2372
Slate & Shells	1570	Lime	2375
Lime	1575	Slate	2418
Slate	1587	Lime	2433
Redrock	1595	Slate	2475
Lime	1605	Lime - Broken	2505
Slate	1618	Slate	2510
Lime	1640	Lime	2516
Slate	1645	Slate	2525
Redrock	1655	Lime	2545

PLUGGING
FILE SEC 27 T 12 R 14w
BOOK PAGE 21 LINE 25

WELL LOG - Claussen #5

Slate	2552	Shale - Blue	2954
Lime	2557	Lansing Lime	2967
Slate	2562	Shale	2968
Lime	2570	Lime	2973
Slate	2619	Shale	2976
Lime	2630	Lime	2978
Slate	2643	Lime, soft	2981
Lime	2670	Lime, hard	2994
Slate CAVE	2677	Lime, soft	3000
Lime - Topeka	2902	Lime	3028
Heebner Shale	2905	Shale	3030
Lime	2910	Lime	3039
Blue Slate CAVE	2921	Slate	3043
Dodge Lime	2937	Lime	3068 T. D.
Redrock	2941		

TOPS

Anhydrite	813'
Topeka	2677'
Heebner	2902'
Lansing	2954'