

STATE OF KANSAS
STATE CORPORATION COMMISSION

WELL PLUGGING RECORD

Give All Information Completely
Make Required Affidavit
Mail or Deliver Report to
Conservation Division
State Corporation Comm.
245 North Water
Wichita, KS 67202


Russell County. Sec. 28 Twp. 12-S Rge. 14 R/W
Location as "NE/CNW 1/4 SW 1/4" or footage from lines _____
C-SW-SE

Lease Owner Abraxas Petroleum Corporation
Lease Name Hopper Well No. 1
Office Address P.O. Box 17485, San Antonio, TX 78217
Character of Well (Completed as Oil, Gas or Dry Hole) _____
Dry Hole

Date Well completed January 2 1979
Application for plugging filed January 4 1979
Application for plugging approved January 4 1979
Plugging commenced January 2 1979
Plugging completed January 2 1979
Reason for abandonment of well or producing formation _____
Dry Hole

If a producing well is abandoned, date of last production _____
19__

Was permission obtained from the Conservation Division or
its agents before plugging was commenced? yes

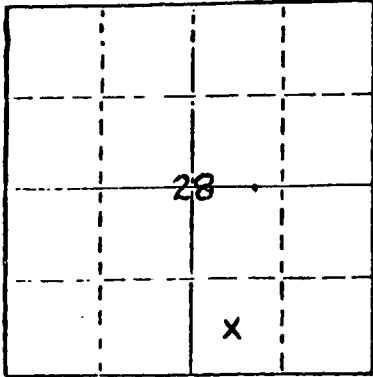

Locate well correctly on above
Section Plat

Name of Conservation Agent who supervised plugging of this well Duane L. Rankin
Producing formation _____ Depth to top _____ Bottom _____ Total Depth of Well 3120'
Show depth and thickness of all water, oil and gas formations.

OIL, GAS OR WATER RECORDS

CASING RECORD

FORMATION	CONTENT	FROM	TO	SIZE	PUT IN	PULLED OUT

Describe in detail the manner in which the well was plugged, indicating where the mud fluid
was placed and the method or methods used in introducing it into the hold. If cement or other
plugs were used, state the character of same and depth placed, from _____ feet to
_____ feet for each plug set.

Cement plugs as follows: 50 Sx. @ 500'
25 sx. @ 185'
solid bridge & plug @ 40'

RECEIVED
STATE CORPORATION COMMISSION
JAN 12 1979 01-12-79
CONSERVATION DIVISION
Wichita, Kansas

(If additional description is necessary, use BACK of this report.)
Name of Plugging Contractor Rains & Williamson and Halliburton

STATE OF TEXAS COUNTY OF BEXAR, ss.
Robert L. G. Watson (employee of owner) or (owner or operator)
of the above-described well, being first duly sworn on oath, says: That I have knowledge of
the facts, statements, and matters herein contained and the log of the above-described well
as filed and that the same are true and correct. So help me God.

(Signature) Robert L. G. Watson
P.O. Box 17485, San Antonio, Texas 78217
(Address)

SUBSCRIBED AND SWORN TO before me this 8th day of January, 1979

Donna C. Simmons
Notary Public.

My commission expires Dec. 1, 1980