


WELL PLUGGING RECORD

Give All Information Completely  
Make Required Affidavit  
Mail or Deliver Report to:  
Conservation Division  
State Corporation Commission  
800 Bittling Building  
Wichita, Kansas

Rooks County. Sec. 34 Twp. 10 Rge. 17 (E) (W)  
Location as "NE/CNW/SW" or footage from lines NE NW SE  
Lease Owner Roland Jones  
Lease Name Brumitt Well No. 1  
Office Address McPherson, Kansas  
Character of Well (completed as Oil, Gas or Dry Hole) Dry Hole  
Date well completed March 10 19 55  
Application for plugging filed March 10 19 55  
Application for plugging approved March 10 19 55  
Plugging commenced 4:30 P.M. March 10 19 55  
Plugging completed 6:00 P.M. March 10 19 55  
Reason for abandonment of well or producing formation Dry Hole

NORTH

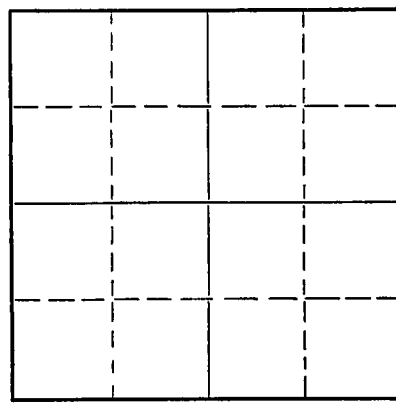

Locate well correctly on above Section Plat

If a producing well is abandoned, date of last production \_\_\_\_\_ 19\_\_\_\_  
Was permission obtained from the Conservation Division or its agents before plugging was commenced? Yes, by telephone

Name of Conservation Agent who supervised plugging of this well Eldon Petty  
Producing formation \_\_\_\_\_ Depth to top \_\_\_\_\_ Bottom \_\_\_\_\_ Total Depth of Well \_\_\_\_\_ Feet  
Show depth and thickness of all water, oil and gas formations.

OIL, GAS OR WATER RECORDS

CASING RECORD

FORMATION	CONTENT	FROM	TO	SIZE	PUT IN	PULLED OUT
				8 5/8"	208 ft.	

Describe in detail the manner in which the well was plugged, indicating where the mud fluid was placed and the method or methods used in introducing it into the hole. If cement or other plugs were used, state the character of same and depth placed, from \_\_\_\_\_ feet to \_\_\_\_\_ feet for each plug set.

Filled hole with mud to 205 ft. Ran 1/3 sack hulls, plug, and 15 sacks cement through drill pipe. Filled hole with mud to 35 ft. Ran 1/3 sack hulls, plug, and 10 sacks cement.

3-14-55


(If additional description is necessary, use BACK of this sheet)  
Name of Plugging Contractor Kiefer & Krause Drilling Co., Inc.  
Address Box 396, Great Bend, Kansas

STATE OF KANSAS, COUNTY OF BARTON  
Richard B. Krause (contractor for owner) or (owner or operator) of the above-described well, being first duly sworn on oath, says: That I have knowledge of the facts, statements, and matters herein contained and the log of the above-described well as filed and that the same are true and correct. So help me God.

(Signature) [Signature]  
for Kiefer & Krause Drilling Co., Inc.  
Box 396, Great Bend, Kansas

SUBSCRIBED AND SWORN TO before me this 12 day of March, 19 55  
[Signature]  
Notary Public.

My commission expires 4-11-55

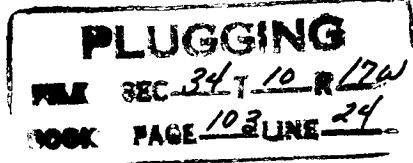

15-163 - 02506 - 0000

DRILLERS LOG

COMPANY: Roland Jones SEC: 34 T10S R17W  
FARM: Brumitt No. 1 LOC: NE NW SE  
Rooks County, Kansas

TOTAL DEPTH: 3535'  
COMM: 2-23-55 COMP: 3-10-55  
CONTRACTOR: Kiefer & Krause Drilling Co., Inc.

CASING: 8 5/8" 208' ELEVATION: 1938' DF

0 40 Surface Clay  
40 60 Shale & Shells  
60 75 Sand  
75 196 Shale  
196 350 Shale & Shells  
350 455 Shale & Red Beds  
455 640 Sand & Shale  
640 990 Shale & Shells  
990 1135 Red Shale & Shells  
1135 1165 Anhydrite  
1165 1175 Shale & Iron  
1175 1453 Shale  
1453 1755 Shale & Red Beds  
1755 1900 Shale & Shells  
1900 1930 Shale & Lime  
1930 2055 Lime  
2055 2185 Shale & Lime  
2185 2305 Lime  
2305 2390 Lime & Shale  
2390 2843 Shale & Lime  
2843 2930 Lime & Shale  
2930 3042 Lime  
3042 3105 Lime & Shale  
3105 3462 Lime  
3462 3480 Lime & Shale  
3480 3535 Lime

Cemented 8 5/8" Casing at 208 ft. with 150 sacks of cement and 2% Calcium Chloride.

RECORDED  
STATE OF KANSAS  
COUNTY OF ROOKS

3535 Total Rotary Depth Plug 1 to 205 ft.; ran 1/3 sack hulls and 15 sacks cement. Plug 2 to 35 ft.; ran 1/3 sack hulls and 10 sacks cement.

I certify that this is the true and correct copy of the above log, to the best of my knowledge.

*Richard P. Krause*  
FOR Kiefer & Krause Drilling Co., Inc.

Subscribed and sworn to before me this 12 day of March, 1955.

*John W. Papp*  
Notary Public

My Commission Expires 4-11-55

PLUGGING  
FILE SEC 34 T 10 R 17W  
BOOK PAGE 103 LINE 24