


STATE OF KANSAS
STATE CORPORATION COMMISSION

Give All Information Completely
Make Required Affidavit
Mail or Deliver Report to:
Conservation Division
State Corporation Commission
212 North Market, Insurance Bldg.
Wichita, Kansas

15-163-19406-0000

R

WELL PLUGGING RECORD

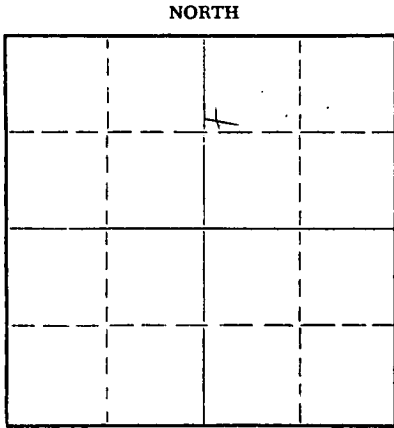

Locate well correctly on above
Section Plat

Rooks _____ County. Sec. 34 Twp. 10 Rge. 17(E) (W)
Location as "NE/CNW/SW" or footage from lines SW NW NE
Lease Owner Manufacturers Supply Co., Inc.
Lease Name Brummitt Well No. 3
Office Address Box 484, Great Bend, Kasas
Character of Well (completed as Oil, Gas or Dry Hole) oil swd
Date well completed _____ 19____
Application for plugging filed September 28, 1959 19____
Application for plugging approved September 30, 1959 19____
Plugging commenced October 7, 1959 19____
Plugging completed October 9, 1959 19____
Reason for abandonment of well or producing formation dry

If a producing well is abandoned, date of last production _____ 19____
Was permission obtained from the Conservation Division or its agents before plugging was commenced? yes

Name of Conservation Agent who supervised plugging of this well Eldon Petty
Producing formation _____ Depth to top _____ Bottom _____ Total Depth of Well 3510 Feet
Show depth and thickness of all water, oil and gas formations.

OIL, GAS OR WATER RECORDS

CASING RECORD

FORMATION	CONTENT	FROM	TO	SIZE	PUT IN	PULLED OUT

Describe in detail the manner in which the well was plugged, indicating where the mud fluid was placed and the method or methods used in introducing it into the hole. If cement or other plugs were used, state the character of same and depth placed, from _____ feet to _____ feet for each plug set.

Sand to 3430 mixed and dumped 4 sacks cement
Pumped 15 sacks fell mud and 20 sacks cement at 500'
20 sacks cement at 150'
10 sacks cement at 40'

RECEIVED
STATE CORPORATION COMMISSION
10-13-59
OCT 13 1959
CONSERVATION DIVISION
Wichita, Kansas

(If additional description is necessary, use BACK of this sheet)
Name of Plugging Contractor Southwest Casing Pulling Co., Inc.
Address Box 364, Great Bend, Kansas

STATE OF Kansas, COUNTY OF Barton, ss.
Southwest Casing Pulling Co., Inc. (employee of owner) or (owner or operator) of the above-described well, being first duly sworn on oath, says: That I have knowledge of the facts, statements, and matters herein contained and the log of the above-described well as filed and that the same are true and correct. So help me God.

(Signature) [Signature] Roy L. Myers Sec. Treas.
Box 364, Great Bend, Kansas
(Address)

SUBSCRIBED AND SWORN TO before me this 12 day of October, 1959

My commission expires December 18, 1962
[Signature] Notary Public.

