


STATE OF KANSAS
STATE CORPORATION COMMISSION

15-167-00599-00-00 Form CP-4
WELL PLUGGING RECORD

Give All Information Completely
Make Required Affidavit
Mail or Deliver Report to:
Conservation Division
State Corporation Commission
211 No. Broadway
Wichita, Kansas

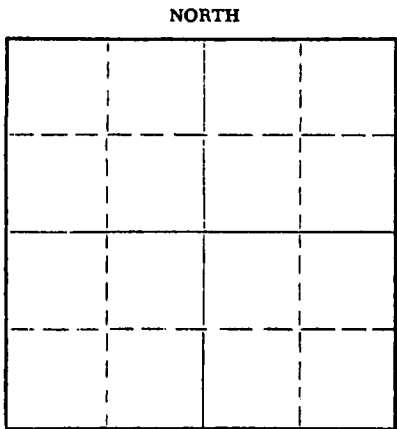

Locate well correctly on above
Section Plat

Russell County. Sec. 1 Twp. 12S Rge. 15 (E) 15 (W)
Location as "NE/CNW&SW&" or footage from lines NE NE NW
Lease Owner Chief Drilling Co., Inc. - Louis Kahan
Lease Name MELLARD Well No. 1
Office Address Box 797 - Gt. Bend, Kansas
Character of Well (completed as Oil, Gas or Dry Hole) Dry Hole
Date well completed 7/19 19 64
Application for plugging filed 7/19 19 64
Application for plugging approved 7/19 19 64
Plugging commenced 7/19 19 64
Plugging completed 7/19 19 64
Reason for abandonment of well or producing formation Dry Hole

If a producing well is abandoned, date of last production _____ 19____
Was permission obtained from the Conservation Division or its agents before plugging was commenced? Yes

Name of Conservation Agent who supervised plugging of this well Donald Truan - Russell, Kansas
Producing formation _____ Depth to top _____ Bottom _____ Total Depth of Well 3189 Feet
Show depth and thickness of all water, oil and gas formations.

OIL, GAS OR WATER RECORDS				CASING RECORD		
FORMATION	CONTENT	FROM	TO	SIZE	PUT IN	PULLED OUT
		0	201	8-5/8"	201	none

Describe in detail the manner in which the well was plugged, indicating where the mud fluid was placed and the method or methods used in introducing it into the hole. If cement or other plugs were used, state the character of same and depth placed, from _____ feet to _____ feet for each plug set.

Pumped heavy mud in hole and squeezed with 80 sacks cement with pump truck.

RECEIVED
STATE CORPORATION COMMISSION

JUL 22 1964
07-22-1964
CONSERVATION DIVISION
Wichita, Kansas

(If additional description is necessary, use BACK of this sheet)
Name of Plugging Contractor Chief Drilling Co., Inc.
Address Box 797 - Gt. Bend, Kansas

STATE OF Kansas, COUNTY OF Barton, ss.
V. Richard Hoover, President (employee of owner) or (owner or operator) of the above-described

well, being first duly sworn on oath, says: That I have knowledge of the facts, statements, and matters herein contained and the log of the above-described well as filed and that the same are true and correct. So help me God.

(Signature) *V. Richard Hoover*
Box 797 - Gt. Bend, Kansas
(Address)

SUBSCRIBED AND SWORN to before me this 21st day of July, 19 64

My commission expires Jan. 26, 1967
Carmen R. Cook Notary Public.

15-167-00599-00-00

WELL LOG

Chief Drilling Co., Inc.
Box 797
Gt. Bend, Kansas

MELLARD #1
NE NE NW Sec. 1-12S-15W
Russell, County, Kansas

Louis Kahan
Box 682
Tulsa, Oklahoma

Commenced: 7/11/64
Completed: 7/19/64

Contractor: Chief Drilling Co., Inc.

Casing Record: Set 8-5/8" @ 201' w/140 sacks Sunset & 2 sacks Gel.

DRY & ABANDONED

<u>FORMATION</u>	<u>FROM</u>	<u>TO</u>	<u>ELEVATION</u>
Shale	0	201	1684 Gr.
Shale & Red Bed	201	757	1686 D.F.
Anhydrite	757	795	1689 K.B.
Shale & Shells	795	1600	
Lime & Shale	1600	2260	
Shale	2260	2675	
Shale & Lime	2675	2807	
Lime & Shale	2807	2856	
Lime	2856	3115	
Shale & Lime	3115	3143	
Conglomerate	3143	3189	
Total Depth	3189		

<u>FORMATION TOPS</u>	
Anhydrite	757 + 930
Heebner	2807 -1118
Toronto	2827 -1138
Lansing-Kansas City	2856 -1167
Base Kansas City	3115 -1426
Conglomerate	3143 -1454
Total Depth	3189 -1500

STATE OF KANSAS, COUNTY OF BARTON) SS

I hereby certify that the above is a true and correct copy of the Driller's Log of the well drilled in the NE NE NW Sec. 1-12S-15W, Russell County, Kansas, to the best of my knowledge and belief.

CHIEF DRILLING CO., INC.

V. Richard Hoover
V. Richard Hoover, President

Subscribed and sworn to before me this 21st day of July, 1964.

Carmen R. Cook
Carmen R. Cook, Notary Public

My commission expires: Jan. 26, 1967.

RECEIVED
STATE CORPORATION COMMISSION

JUL 22 1964
07-22-1964
CONSERVATION DIVISION
Wichita, Kansas