


15-167-21042-00-00

STATE OF KANSAS
STATE CORPORATION COMMISSION

WELL PLUGGING RECORD

Give All Information Completely
Make Required Affidavit
Mail or Deliver Report to
Conservation Division
State Corporation Comm.
245 North Water
Wichita, KS 67202

Russell County. Sec. 1 Twp. 12S Rge. 15W E/W
Location as "NE/CNW $\frac{1}{4}$ SW $\frac{1}{4}$ " or footage from lines
NE SW NW
Lease Owner PICKRELL DRILLING COMPANY
Lease Name NEWMAN "B" Well No. 1
Office Address 205 LITWIN BLDG., WICHITA, KS, 67202
Character of Well (Completed as Oil, Gas or Dry Hole)

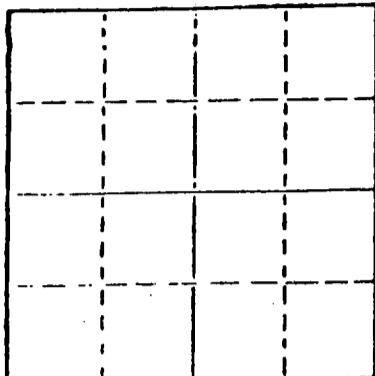

Locate well correctly on above
Section Plat

Dry Hole
Date Well completed 4-27-77 19
Application for plugging filed 4-27-77 19
Application for plugging approved 4-27-77 19
Plugging commenced 4-27-77 19
Plugging completed 4-27-77 19
Reason for abandonment of well or producing formation
Dry Hole

If a producing well is abandoned, date of last production 19

Was permission obtained from the Conservation Division or
its agents before plugging was commenced? Yes

Name of Conservation Agent who supervised plugging of this well Duane L. Rankin
Producing formation Depth to top Bottom Total Depth of Well 3325
Show depth and thickness of all water, oil and gas formations.

OIL, GAS OR WATER RECORDS

CASING RECORD

FORMATION	CONTENT	FROM	TO	SIZE	PUT IN	PULLED OUT
				8 5/8	214	None

Describe in detail the manner in which the well was plugged, indicating where the mud fluid
was placed and the method or methods used in introducing it into the hold. If cement or other
plugs were used, state the character of same and depth placed, from feet to
feet for each plug set.

40 sacks at 480'
20 sacks at 210'
10 sacks at 40'
5 sacks in Rate Hole Comp. 10PM 4-27-77

RECEIVED
STATE CORPORATION COMMISSION

MAY 16 1977
05-16-1977
CONSERVATION DIVISION
Wichita, Kansas

(If additional description is necessary, use BACK of this sheet)
Name of Plugging Contractor PICKRELL DRILLING COMPANY

STATE OF Kansas COUNTY OF Sedgwick, ss.
C. W. Sebitts (employee of owner) or (owner or operator)

of the above-described well, being first duly sworn on oath, says: That I have knowledge of
the facts, statements, and matters herein contained and the log of the above-described well
as filed and that the same are true and correct. So help me God. BY: C. W. Sebitts

(Signature) *[Signature]*
205 Litwin Bldg., Wichita, Ks. 67202
(Address)

SUBSCRIBED AND SWORN TO before me this 10 day of May, 1977

My commission expires



[Signature]
Jo Ann Sarver Notary Public.

15-167-21042-00-00

ROTARY DRILLING LOG

COMPANY: PICKRELL DRILLING COMPANY
205 LITWIN BLDG.
WICHITA, KS. 67202
LOCATION: Newman "B" #1
NE SW NW Sec. 1-12S-15W
Russell Co., Ks.

Rotary Drilling Commenced 4-19-77
Rotary Drilling Completed 4-27-77

CONTRACTOR: **PICKRELL DRILLING COMPANY**
Wichita, Kansas

CASING RECORD: Spud date 4-19-77 Surface pipe 8 5/8" @ 214' with 140sx. Comp.
4-19-77 @ 2:00PM

LOG

(Figures indicate bottom of formation — measurements from top of rotary bushing.)

Top Soil	28
Post Rock & Shale	180
Shale	216
Shale	260
Shale & Sand	432
Shale	447
Shale	830
Shale	847
Shale	894
Shale	977
Shale	1360
Shale	1495
Shale & Lime	1750
Lime	1840
Lime	2045
Shale & Lime	2240
Lime & Shale	2340
Shale & Lime	2490
Lime	2640
Lime & Shale	2700
Shale	2730
Lime	2825
Lime & Shale	2935
Lime	3010
Lime	3015
Lime & Shale	3052
Shale & Lime	3080
Lime	3155
Lime	3163
Lime	3215
Lime	3275
Lime	3325

RECEIVED
STATE CORPORATION COMMISSION
MAY 16 1977
05-16-1977
CONSERVATION DIVISION
Wichita, Kansas

C. W. Sebitts

The undersigned, _____, Attorney-in-Fact for PICKRELL DRILLING COMPANY, hereby certifies in behalf of said Company, that the above is a true and correct log of the formation encountered in drilling the above well as reflected by the Daily Drilling Reports.

PICKRELL DRILLING COMPANY
By [Signature]
Attorney-in-Fact
C. W. Sebitts

STATE OF KANSAS }
COUNTY OF SEDGWICK } ss.:

On this 10 day of May, 1977, before me the undersigned, a Notary Public, in and for the County and State aforesaid, personally appeared C. W. Sebitts

to me known to be the identical person who subscribed the name of PICKRELL DRILLING COMPANY to the foregoing instrument as its Attorney-in-Fact and acknowledged to me that he executed the same as his free and voluntary act and deed, and as the free and voluntary act and deed of such company, for the uses and purposes therein set forth.

Given under my hand and seal of office the day and year last above written.



My commission expires: _____

[Signature]
Notary Public
Jo Ann Sarver