


15-167-01780-00-00

STATE OF KANSAS
STATE CORPORATION COMMISSION

WELL PLUGGING RECORD

Give All Information Completely
Make Required Affidavit
Mail or Deliver Report to:
Conservation Division
State Corporation Commission
212 No. Market
Wichita, Kansas 67202

NORTH

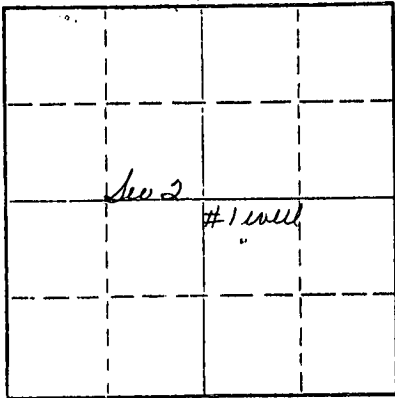

Locate well correctly on above
Section Plat

Russell County, Sec. 2 Twp. 12 Rge. 15-W(E) (W)

Location as "NE/CNW%SW%" or footage from lines _____

Lease Owner Burns Oil Company

Lease Name Shaffer Well No. #1

Office Address Box 449, Russell, Kansas 67665

Character of Well (completed as Oil, Gas or Dry Hole) Oil

Date well completed See well log 19

Application for plugging filed March 14, 1970 19

Application for plugging approved March 16, 1970 19

Plugging commenced March 26, 1970 19

Plugging completed March 26, 1970 19

Reason for abandonment of well or producing formation No production

If a producing well is abandoned, date of last production Refer to well log 19

Was permission obtained from the Conservation Division or its agents before plugging was commenced? Yes

Name of Conservation Agent who supervised plugging of this well Don Truan

Producing formation Arbuckle Depth to top _____ Bottom _____ Total Depth of Well 3170 Feet

Show depth and thickness of all water, oil and gas formations.

OIL, GAS OR WATER RECORDS

CASING RECORD

FORMATION	CONTENT	FROM	TO	SIZE	PUT IN	PULLED OUT
				8-5/8	186	none
				5-1/2	3160	none

Describe in detail the manner in which the well was plugged, indicating where the mud fluid was placed and the method or methods used in introducing it into the hole. If cement or other plugs were used, state the character of same and depth placed, from _____ feet to TD 3170 feet for each plug set.

5 1/2" casing set at 3160. No pipe recovery.

Squeezed well with 3 sacks of bulls; 10-sacks of mud; 100 sacks of cement with Allied Cementing Company pump truck.

Cemented from 450 feet to base of cellar.

RECEIVED
STATE CORPORATION COMMISSION

APR 22 1970

CONSERVATION DIVISION
Wichita, Kansas

04-22-1970

(If additional description is necessary, use BACK of this sheet)

Name of Plugging Contractor Same--with Allied Cementing Company.

Address Box 207, Russell, Kansas 67665

STATE OF Kansas, COUNTY OF Russell, ss.

(employee of owner) or (owner or operator) of the above-described well, being first duly sworn on oath, says: That I have knowledge of the facts, statements, and matters herein contained and the log of the above-described well as filed and that the same are true and correct. So help me God.

(Signature) A. H. Flocks

Box 449, Russell, Kansas 67665
(Address)

SUBSCRIBED AND SWORN TO before me this 21st day of April, 1970

Lein E. Holaya
Notary Public.

July 25, 1972

