

STATE OF KANSAS
STATE CORPORATION COMMISSION


Give All Information Completely
Make Required Affidavit
Mail or Deliver Report to:
Conservation Division
State Corporation Commission
800 Bitting Building
Wichita, Kansas

OR

FORMATION PLUGGING RECORD

Strike out upper line
when reporting plugging
of formations.

Russell County. Sec. 2 Twp. 12 Rge. (E) 15 (W)
Location as "NE $\frac{1}{4}$ NW $\frac{1}{4}$ SW $\frac{1}{4}$ " or footage from lines NE, NW, NW,
Lease Owner JONES, SHELburnE & FARMER, INC.
Lease Name Shaffer Well No. 1
Office Address Russell, Kansas
Character of Well (completed as Oil, Gas or Dry Hole) Dry Hole
Date well completed 10/21/49 19
Application for plugging filed 10/20/49 19
Application for plugging approved 10/20/49 19
Plugging commenced 10/21/49 19
Plugging completed 10/21/49 19
Reason for abandonment of well or producing formation Dry Hole
If a producing well is abandoned, date of last production Never Produced 19
Was permission obtained from the Conservation Division or its agents before plugging was commenced? Yes

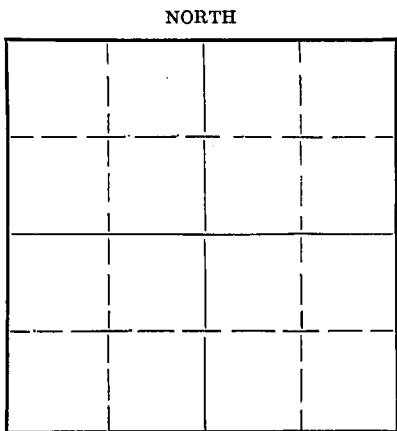

Locate well correctly on above
Section Plat

Name of Conservation Agent who supervised plugging of this well Eldon Petty
Producing formation None Depth to top 3220 Bottom Total Depth of Well 3220 Feet
Show depth and thickness of all water, oil and gas formations.

OIL, GAS OR WATER RECORDS

CASING RECORD

Formation	Content	From	To	Size	Put In	Pulled Out
<u>Rotary Hole</u>				<u>8 5/8"</u>	<u>200'</u>	<u>None</u>

Describe in detail the manner in which the well was plugged, indicating where the mud fluid was placed and the method or methods used in introducing it into the hole. If cement or other plugs were used, state the character of same and depth placed, from feet to feet for each plug set.

1. Pits jetted and heavy mud displaced into hole.
2. Wooden plug spotted at 200'.
3. Fifteen sacks cement mixed and spotted on top of plug through drill pipe.
4. Hole filled to within 20' of top with heavy mud, and another wooden plug spotted at 20'.
5. Ten sacks cement mixed and spotted on top of plug.

RECEIVED
OCT 24 1949
OCT 24 1949
STATE CORPORATION COMMISSION
KANSAS

(If additional description is necessary, use BACK of this sheet)

Correspondence regarding this well should be addressed to JONES, SHELburnE & FARMER, INC.
Address Russell, Kansas

STATE OF KANSAS, COUNTY OF RUSSELL, ss.
John O. Farmer (employee of owner) or (owner or operator) of the above-described well,
being first duly sworn on oath, says: That I have knowledge of the facts, statements, and matters herein contained and the log of the above-described well as filed and that the same are true and correct. So help me God

(Signature) John O. Farmer

(Address)

SUBSCRIBED AND SWORN to before me this 22 day of October, 1949

Phyllis Bethany

Notary Public.

My commission expires June 3, 1953

27-2025 2-48-15M
PLUGGING
FILE SEC 7 T 12 R 15W
BOOK PAGE 170 LINE 44

Jones, Shelburne & Farmer, Inc.

Russell, Kansas

15-167-00380-00-00

CONTRACTOR'S VERIFIED LOG

Operator JONES, SHELBURNE & FARMER, INC Farm Name SHAFFER Well No. 1

Location NE, NW, NW, SECTION 2-12-15

Pool Name _____ County RUSSELL State KANSAS

Commencement Date October 11, 1949 Completion Date October 20, 1949

Log of Well

Depth		Formation	Deviation from vertical (degrees)	Remarks
From	To			
0	40	Shale		
40	300	Shale and Shells		
300	360	Shale, Shells and Red Beds		
360	470	Pyrite and Shells		
470	520	Sand and Shale		
520	775	Shale and Shells		
775	825	Anhydrite		
825	1530	Shale and Shells		
1530	2545	Lime and Shale		
2545	2830	Shale and Lime		
2830	3220	Lime		
	3220	Total Depth		
		Andhydrite 775'		
		Heebner Shale 2830'		
		Simpson Shale 3205'		
		Arbuckle Dolomite 3207'		

RECEIVED
 15-167-027949
 OCT 24 1949
 STATE OF KANSAS
 COMMISSIONER OF GEOLOGY

PLUGGING
 FILE SEC 2 T18 R15W
 BOOK PAGE LINE 44

Depth		Formation	Deviation from vertical (degrees)	Remarks
From	To			
			Total Depth	

Was well to be deepened by another Contractor? _____

CASING LEFT IN HOLE AFTER COMPLETION OR ABANDONMENT

Size	Wt.	Grade	Range	Thread	FOOTAGE						
					Delivered	Run	Set At	Unused	Pulled	Left in Hole	

Deviation From Vertical Data Is Correct as Shown

Company Superintendent

(This space for Company use)

The foregoing Well Log and other data are correct.

JONES, SHELBURNE & FARMER, Inc.
Contractor

By _____