


STATE OF KANSAS  
STATE CORPORATION COMMISSION

Give All Information Completely  
Make Required Affidavit  
Mail or Deliver Report to:  
Conservation Division  
State Corporation Commission  
211 No. Broadway  
Wichita, Kansas

15-167-00099-00-00

WELL PLUGGING RECORD

NORTH

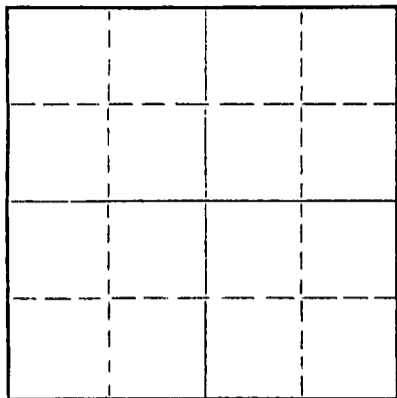

Locate well correctly on above  
Section Plat

Russell County. Sec. 2 Twp. 12S Rge. (E) 15 (W)

Location as "NE/CNW/SW" or footage from lines W/2 NW/4 SW/4

Lease Owner Icer Addis

Lease Name Shaffer Well No. 1

Office Address Russell, Kansas

Character of Well (completed as Oil, Gas or Dry Hole) Dry Hole

Date well completed 8-20 19 59

Application for plugging filed 8-20 19 59

Application for plugging approved 8-20 19 59

Plugging commenced 8-20 19 59

Plugging completed 8-20 19 59

Reason for abandonment of well or producing formation Dry Hole

If a producing well is abandoned, date of last production 19

Was permission obtained from the Conservation Division or its agents before plugging was commenced? yes

Name of Conservation Agent who supervised plugging of this well

Producing formation Depth to top Bottom Total Depth of Well 3310 Feet

Show depth and thickness of all water, oil and gas formations.

OIL, GAS OR WATER RECORDS

CASING RECORD

FORMATION	CONTENT	FROM	TO	SIZE	PUT IN	PULLED OUT

RECEIVED  
STATE CORPORATION COMMISSION  
SEP 30 1959  
09-30-1959  
CONSERVATION DIVISION  
Wichita, Kansas

Describe in detail the manner in which the well was plugged, indicating where the mud fluid was placed and the method or methods used in introducing it into the hole. If cement or other plugs were used, state the character of same and depth placed, from feet to feet for each plug set.

Set 8 5/8" at 260' with 140 sacks of cement. Heavy mud to 250'.  
1/4 sack hulls. Plug. 25 sacks of cement pure were poured thru drill  
pipe. Mud to 35'. 1/4 sack hulls. Plug. 10 sacks of cement. 2 sacks in rat  
hole.

(If additional description is necessary, use BACK of this sheet)

Name of Plugging Contractor Mast Drilling, Inc.

Address Russell, Kansas

STATE OF Kansas COUNTY OF Russell, ss. Contractor  
James J. Thoman (employee of owner) or (owner or operator) of the above-described  
well, being first duly sworn on oath, says: That I have knowledge of the facts, statements, and matters herein contained and the log of the  
above-described well as filed and that the same are true and correct. So help me God.  
(Signature) James J. Thoman Mast Drilling, Inc.  
JAMES J. THOMAN, Secty-Treas.

SUBSCRIBED AND SWORN TO before me this 29<sup>th</sup> day of September, 19 59

My commission expires 8-9-62  
Betty Jean Galgout Notary Public.



15-167-00099-00-00

WELL LOG

OPERATOR: Icer Addis  
Russell, Kansas

CONTRACTOR: Mast Drilling, Inc.  
Russell, Kansas

LEASE: Shaffer No. 1  
W/2 NW/4 SW/4  
Sec. 2, T12S, R15W  
Russell County, Kansas

COMMENCED: 9-11-59

COMPLETED: 9-20-59

FORMATION	DEPTH
Surface Clay	30
Rock	90
Sand-Shale-Shells	280
Shale	340
Shale-Shells	815
Red Bed	873
Anhydrite	904
Shale-Shells	1220
Salt-Shale	1525
Shale-Lime	1630
Shale-Broken Lime	1760
Shale-Lime	2545
Shale-Lime Shell	2693
Lime	2781
Shale-Lime	2878
Lime	3176
Shale-Lime-Pyrite Streaks	3270
Lime	3300
Arbuckle	3310
TOTAL DEPTH	3310

RECEIVED  
09-30-1959  
SEP 20 1959  
CONSERVATION DIVISION  
TOPEKA, KANSAS

I hereby certify that the above is true and correct to the best of my knowledge.

Mast Drilling, Inc.  
*James J. Thoman*  
JAMES J. THOMAN, Secty-Treas.

STATE OF KANSAS )  
                          )ss  
COUNTY OF RUSSELL)

Subscribed and sworn to before me this 28th day of September, 1959.

*Betty Jean Salyard*

My Commission expires 8-9-62.