

This form shall be filed in duplicate with the Kansas Corporation Commission, 200 Colorado Derby Building, Wichita, Kansas 67202, within ten days after the completion of the well, regardless of how the well was completed.

Attach separate letter of request if the information is to be held confidential. If confidential, only file one copy. Information on side one will be of public record and side two will then be held confidential.

Circle one: Oil Gas, Dry, SWD, OWWO, Injection. Type and complete ALL sections. Applications must be filed for dual completion, commingling, SWD and injection, T.A.

Attach wireline logs (i.e. electrical log, sonic log, gamma ray neutron log, etc.). KCC # (316) 263-3238. (Rules 82-2-105 & 82-2-125)

OPERATOR Horizon Petroleum Corporation

API NO. 163 - 21,682 - 0000

ADDRESS Riverfront Place, 833 N. Waco
Wichita, Kansas 67203

COUNTY Rooks

FIELD

**CONTACT PERSON Jerry Hoggatt
PHONE 316/267-8416

PROD. FORMATION Conglomerate

PURCHASER Koch Oil Company

LEASE FRITZ

ADDRESS P.O. Box 2256
Wichita, Kansas 67530

WELL NO. #2


WELL LOCATION C N/2 SE SW

DRILLING Duke Drilling Co., Inc.
CONTRACTOR P.O. Box 823
ADDRESS Great Bend, KS 67530

660 Ft. from East Line and
990 Ft. from South Line of
the SW 1/4 SEC. 9 TWP. 10S RGE. 17W

PLUGGING
CONTRACTOR
ADDRESS

WELL PLAT

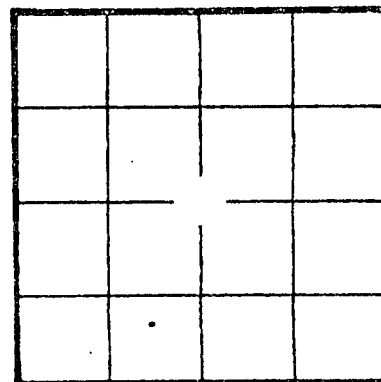

KCC
KGS
(Office Use)

TOTAL DEPTH 3690' PBD

SPUD DATE 5-10-82 DATE COMPLETED 5-17-82

ELEV: GR 2075 DF KB 2079'

DRILLED WITH (CABLE) (ROTARY) (AIR) TOOLS

Amount of surface pipe set and cemented 257'. DV Tool Used? (Back side squeeze. 424 sks. 200 sks. common; 200 sks posmix; 24 sks gel.)

AFFIDAVIT

STATE OF Kansas, COUNTY OF Sedgwick SS, I,

Jerry D. Hoggatt OF LAWFUL AGE, BEING FIRST DULY SWORN UPON HIS OATH,

DEPOSES THAT HE IS President (FOR)(OF) Horizon Petroleum Corporation

OPERATOR OF THE Fritts LEASE, AND IS DULY AUTHORIZED TO MAKE

THIS AFFIDAVIT FOR BEHALF OF SAID OPERATOR, THAT WELL NO. 2 ON

SAID LEASE HAS BEEN COMPLETED ON THE 14th DAY OF June, 1982, AND THAT


ALL INFORMATION CONTAINED HEREIN WITH RESPECT TO SAID WELL IS TRUE AND CORRECT.

FURTHER AFFIANT SAITH

STATE RECEIVED JUL 15 1982 CONSERVATION DIVISION Wichita, Kansas

(S) Jerry D. Hoggatt
Jerry D. Hoggatt

SUBSCRIBED AND SWORN BEFORE ME THIS 14th DAY OF July, 1982.

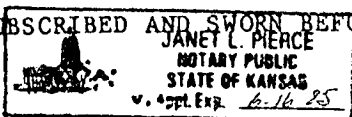

Janet L. Pierce
NOTARY PUBLIC

MY COMMISSION EXPIRES: 6-16-85

**The person who can be reached by phone regarding any questions concerning this information. Within 45 days of completion, a witnessed initial test by the Commission is required if the well produces more than 25 BOPD or is located in a Basic Order Pool.