

KANSAS CORPORATION COMMISSION
OIL & GAS CONSERVATION DIVISION

Form CP-1
September 2003
Form must be Typed
Form must be Signed
All blanks must be Filled

WELL PLUGGING APPLICATION

Please TYPE Form and File ONE Copy

API # 15- 187-20971-0000 (Identifier Number of this well). This must be listed for wells drilled since 1967; if no API # was issued.

Indicate original spud or completion date 9/25/2001 (spud)

Well Operator: Presco Western, LLC KCC License #: 32309
(Owner/Company Name) (Operator's)

Address: 5665 Flatiron Parkway City: Boulder

State: CO Zip Code: 80301 Contact Phone: 303 305-1163

Lease: Western Feed Yard Well #: 2-1433 Sec. 33 Twp. 28 R. 40 East West

C - SE - SE - SW Spot Location/QQQQ County Stanton

442 Feet from (in exact footage) North South (from nearest outside section corner) Line of Section (not Lease Line)

2,299 Feet from (in exact footage) East West (from nearest outside section corner) Line of Section (not Lease Line)

Check One: Oil Well Gas Well D&A Cathodic Water Supply Well
 SWD Docket # _____ ENHR Docket # _____ Other _____

Conductor Casing Size: _____ Set at: _____ Cemented with: _____ Sacks

Surface Casing Size: 8-5/8" Set at: 1,727' Cemented with: approx. 725 Sacks

Production Casing Size: 5-1/2" Set at: 5,509' Cemented with: 275 Sacks

List (ALL) Perforations and Bridgeplug Sets: 5,415 - 5,429' (Morrow)

Elevation: 3,285' (G.L. K.B.) T.D. _____ PBDT _____ Anhydrite Depth _____
(Stone Corral Formation)

Condition of Well: Good Poor Casing Leak Junk in Hole

Proposed Method of Plugging (attach a separate page if additional space is needed): Plug 1: CIBP @ +/- 5.370' w/ 2 SKS cmt. Plug
2 & 3: Shoot squeeze perfs @ +/- 1.750', circulate cmt to surface, leave 50 SKS in csq. Plug 4: 50 SKS
cmt @ +/- 600'. Plug 5: 20 SKS @ surface.

Is Well Log attached to this application as required? Yes No Is ACO-1 filed? Yes No

If not explain why? No ACO-1 on record from original operator (Wabash Production).

Plugging of this Well will be done in accordance with K.S.A. 55-101 et. seq. and the Rules and Regulations of the State Corporation Commission

List Name of Company Representative authorized to be in charge of plugging operations:

Steve Ridenour Phone: 620 655-3459

Address: 303 S. Stubbs Rd. City/State Ulysses/KS 67880

Plugging Contractor Presco Western (Basic Energy) KCC License # 32309
(Company Name) (Contractor's)

Address 5665 Flatiron Parkway Phone: 303 305-1163

Proposed Date and Hour of Plugging (if known?): _____

Payment of the Plugging Fee (K.A.R. 82-3-118) will be guaranteed by Operator or Agent

Date: 6/12/2009 Authorized Operator / Agent: Keli Kowalski

(Signature)

Keli Kowalski

Mail to: KCC - Conservation Division, 130 S. Market - Room 2078, Wichita, Kansas 67202

KANSAS CORPORATION COMMISSION

JUN 15 2009

RECEIVED

Dist
PRT


ELLORA ENERGY

Stanton Cty.

WESTERN FEED YARD 2-1433

15-187-20971

PROPOSED

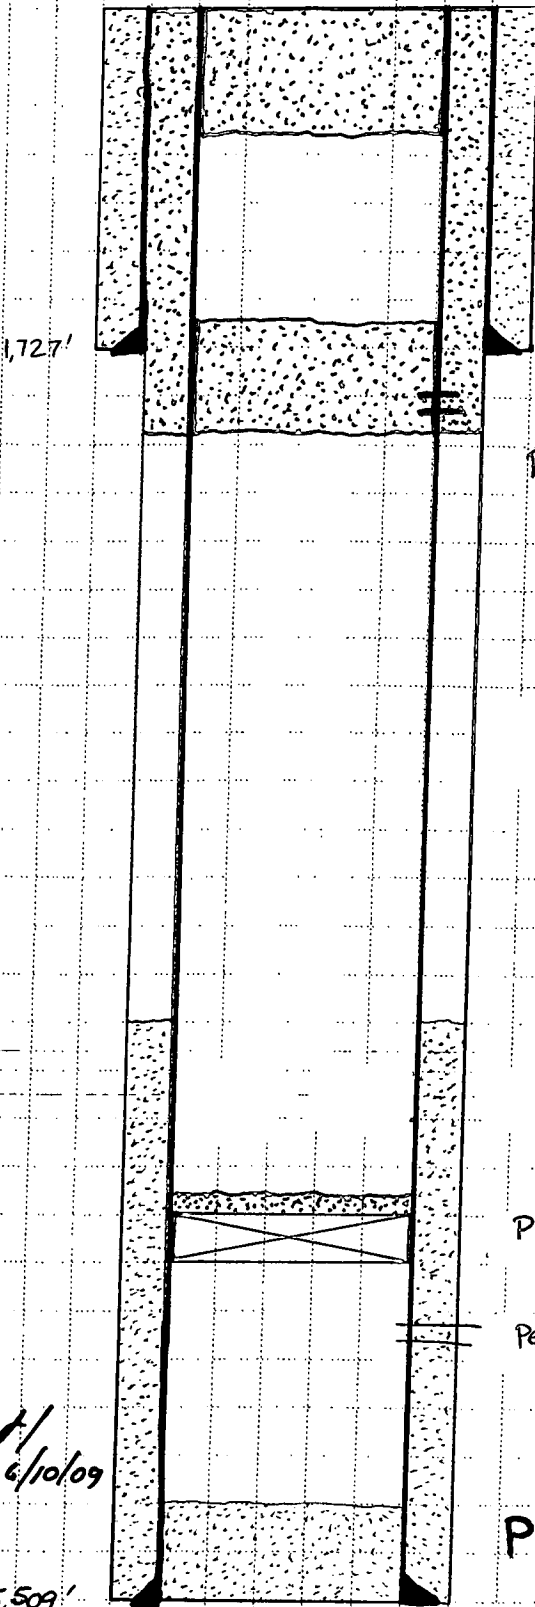

Plug #5: 20 SK @ surface

PLUG #4 - ~~60~~ SKS CMT @ +/- 600'
50

SURFACE CSG

8 5/8" @ 1,727'

PLUGS #2 & #3 - SHOOT SQUEEZE PERFS
@ +/- 1,750', CIRCULATE CMT TO
SURFACE, LEAVE ~~20~~ SKS IN CSG
50

KANSAS CORPORATION COMMISSION

JUN 15 2009

RECEIVED

PLUG #1 - CIBP @ +/- 5,370' w/ 2 SKS CMT

PERFS 5,415' - 5,429' (MORROW)

PRODUCTION CSG

5 1/2" @ 5,509'

*Verbal - Permit/
Voted on 6/10/09

5,509'



CORPORATION COMMISSION

Mark Parkinson, Governor Thomas E. Wright, Chairman Michael C. Moffet, Commissioner Joseph F. Harkins, Commissioner

NOTICE OF RECEIPT OF WELL PLUGGING APPLICATION (CP-1)

PRESKO WESTERN LLC
5665 FLATIRON PKWY
BOULDER, CO 80301

June 22, 2009

Re: WESTERN FEED YARD #2-1433
API 15-187-20971-00-00
33-28S-40W, 442 FSL 2299 FWL
STANTON COUNTY, KANSAS

Dear Operator:

This letter is to notify you that the Conservation Division has received your plugging proposal, form CP-1, for the above well and has reviewed the proposal for completeness. The central office will now forward your CP-1 to the district office listed below for review of the proposed plugging method. **Please contact the district office for approval of your proposed plugging method at least five (5) days before plugging the well, pursuant to K.A.R. 82-3-113(b). If a workover pit will be used during the plugging of the well it must be permitted. A CDP-1 form must be filed and approved prior to the use of the pit in accordance with K.A.R. 82-3-600.**

The Conservation Division's review of form CP-1, either in the central or district office, does not include an inquiry into well ownership or the filing operator's legal right to plug the well. This notice in no way constitutes authorization to plug the above well by persons not having legal rights of ownership or interest in the well.

This notice is void after December 19, 2009. The CP-1 filing does not bring the above well into compliance with K.A.R. 82-3-111 with regard to the Commission's temporary abandonment requirements.

Sincerely,

Steve Bond
Production Department Supervisor

District: #1
210 E Frontview, Suite A
Dodge City, KS 67801
(620) 225-8888