

KANSAS CORPORATION COMMISSION  
OIL & GAS CONSERVATION DIVISION

Form CP-1  
September 2003  
Form must be Typed  
Form must be Signed  
All blanks must be Filled

WELL PLUGGING APPLICATION

Please TYPE Form and File ONE Copy

API # 15- 187-20762-0000 (Identifier Number of this well). This must be listed for wells drilled since 1967; if no API # was issued.

Indicate original spud or completion date 1/16/1995

Well Operator: Presco Western, LLC KCC License #: 32309

Address: 5665 Flatiron Parkway (Owner/Company Name) City: Boulder (Operator's)

State: CO Zip Code: 80301 Contact Phone: 303 305-1163

Lease: Elliot Spencer Well #: 1-17 Sec. 17 Twp. 30 R. 39  East  West

C - C - SE - NE Spot Location/QQQQ County Stanton

3.300 Feet from (in exact footage)  North /  South (from nearest outside section corner) Line of Section (not Lease Line)

660 Feet from (in exact footage)  East /  West (from nearest outside section corner) Line of Section (not Lease Line)

Check One:  Oil Well  Gas Well  D&A  Cathodic  Water Supply Well  
 SWD Docket # \_\_\_\_\_  ENHR Docket # \_\_\_\_\_  Other \_\_\_\_\_

Conductor Casing Size: \_\_\_\_\_ Set at: \_\_\_\_\_ Cemented with: \_\_\_\_\_ Sacks

Surface Casing Size: 8-5/8" Set at: 1,800' Cemented with: 750 Sacks

Production Casing Size: 5-1/2" Set at: 5,900' Cemented with: 200 Sacks

List (ALL) Perforations and Bridgeplug Sets: 5,610 - 5,628' (Morrow)

Elevation: 3,208 ( G.L.  K.B.) T.D. 5,900' PBDT \_\_\_\_\_ Anhydrite Depth \_\_\_\_\_  
(Stone Corral Formation)

Condition of Well:  Good  Poor  Casing Leak  Junk in Hole

Proposed Method of Plugging (attach a separate page if additional space is needed): CIBP @ +/- 5.570' w/ 2 SKS cmt. Plug # 2 @ +/- 2.950' w/ 20 SKS cmt. Plug # 3 @ +/- 1.810' w/ 20 SKS cmt. Plug # 4 @ +/- 600' w/ 50 SKS. Plug # 5 Dump cmt down surface csq w/ 20 SKS @ surface (inside csq).

Is Well Log attached to this application as required?  Yes  No Is ACO-1 filed?  Yes  No

If not explain why? \_\_\_\_\_

KANSAS CORPORATION COMMISSION

JUN 15 2009

RECEIVED

Plugging of this Well will be done in accordance with K.S.A. 55-101 et seq. and the Rules and Regulations of the State Corporation Commission

List Name of Company Representative authorized to be in charge of plugging operations:

Steve Ridenour Phone: 620 655-3459

Address: 303 S. Stubbs Rd. City/State Ulysses/KS 67880

Plugging Contractor Presco Western (Basic Energy) LLC KCC License # 32309  
(Company Name) (Contractor's)

Address 5665 Flatiron Parkway, Boulder/CO 80301 Phone: 303 305-1163

Proposed Date and Hour of Plugging (if known?): \_\_\_\_\_

Payment of the Plugging Fee (K.A.R. 82-3-118) will be guaranteed by Operator or Agent

Date: 6/12/2009 Authorized Operator / Agent: Keli Kowalski

(Signature)


Keli Kowalski

Dist 1  
PPT

Stanton Cty.

ELLIOT SPENCER 1-17  
15-187-20762

PROPOSED

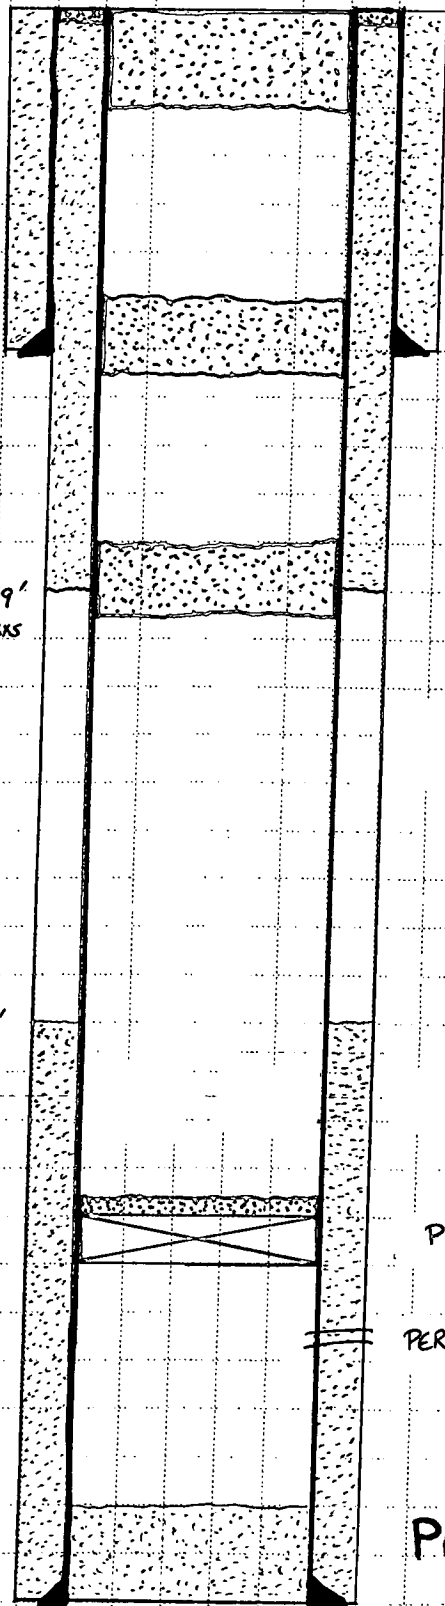

PLUG #5 - DUMP CMT DOWN SURFACE CSG  
w/20 SX @ surface (inside CSG.)

PLUG #4 - ~~60~~ 50 SX @ +/- 600'

**SURFACE CSG**

8 5/8" 24 # J-55 @ 1,800'

CMT'D w/ 750 SX

PLUG #3 - 20 SX @ +/- 1,810'

PLUG #2 - 20 SX @ +/- 2,950'

DV TOOL @ 2,949'  
CMT'D w/ 450 SX

KANSAS CORPORATION COMMISSION

JUN 15 2009

RECEIVED

PLUG #1 - CIBP @ +/- 5,570' w/ 2 SX CMT

PERFS 5,610' - 5,628' (MORROW)

**PRODUCTION CSG**

5 1/2" 14 # CF-50 @ 5,900'

CMT'D w/ 450 SX



CORPORATION COMMISSION

Mark Parkinson, Governor Thomas E. Wright, Chairman Michael C. Moffet, Commissioner Joseph F. Harkins, Commissioner

**NOTICE OF RECEIPT OF WELL PLUGGING APPLICATION (CP-1)**

PRESKO WESTERN LLC  
5665 FLATIRON PKWY  
BOULDER, CO 80301

June 22, 2009

Re: ELLIOT SPENCER #1-17  
API 15-187-20762-00-00  
17-30S-39W, 3300 FSL 660 FEL  
STANTON COUNTY, KANSAS

Dear Operator:

This letter is to notify you that the Conservation Division has received your plugging proposal, form CP-1, for the above well and has reviewed the proposal for completeness. The central office will now forward your CP-1 to the district office listed below for review of the proposed plugging method. **Please contact the district office for approval of your proposed plugging method at least five (5) days before plugging the well, pursuant to K.A.R. 82-3-113(b). If a workover pit will be used during the plugging of the well it must be permitted. A CDP-1 form must be filed and approved prior to the use of the pit in accordance with K.A.R. 82-3-600.**

The Conservation Division's review of form CP-1, either in the central or district office, does not include an inquiry into well ownership or the filing operator's legal right to plug the well. This notice in no way constitutes authorization to plug the above well by persons not having legal rights of ownership or interest in the well.

**This notice is void after December 19, 2009. The CP-1 filing does not bring the above well into compliance with K.A.R. 82-3-111 with regard to the Commission's temporary abandonment requirements.**

Sincerely,

Steve Bond  
Production Department Supervisor

District: #1  
210 E Frontview, Suite A  
Dodge City, KS 67801  
(620) 225-8888