

15-167-06222-00-00

DISTRICT CONSERVATION AGENT'S REPORT

TO:

State Corporation Commission
Conservation Division
800 Bitting Building
Wichita, Kansas

FILE NO. 57-13
LOCATION SW SW NW
SEC. 2 TWP. 12 RGE. 15W

Dry Hole Abandoned Oil Well Abandoned Gas Well

I have today completed supervision of plugging of:


Well No. 1 Lease Sutton
Operator Auto Balance Corporation Address 517 Union Natl Bank Bldg Wichita ^{Kans}
Field County Russell

Total Depth 3310 PB 3274 Feet.

(Describe briefly the manner in which the well was plugged)

Hole filled with cement from 3276 to
3250 and mud and bridge to 290 and
cement to 270 and mud and bridge to 18 ft
and cement to 6

PLUGGING
FILE 57-13-15W
BOOK PAGE 57 LINE 12

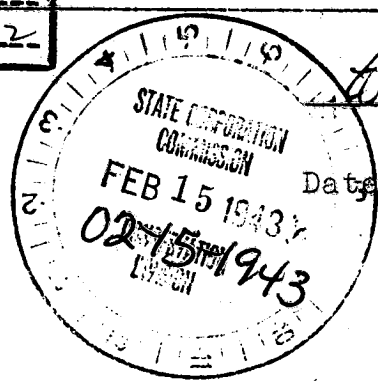

T. Alexander
District Conservation Agent

Date 2-13-43