


15-167-00096-00-00

WELL PLUGGING RECORD

Give All Information Completely
Make Required Affidavit
Mail or Deliver Report to:
Conservation Division
State Corporation Commission
800 Biting Building
Wichita, Kansas

Russell County. Sec. 32 Twp. 12 Rge. 11 (E) W (W)
Location as "NE/CNW/SW" or footage from lines S/2 SE-SE
Lease Owner Albert W. Borell and Henry Miller, Jr.
Lease Name Heine Well No. 1
Office Address P. O. Box 33 Russell, Kansas
Character of Well (completed as Oil, Gas or Dry Hole) Dry Hole
Date well completed April 29 19 53
Application for plugging filed _____ 19 _____
Application for plugging approved April 30 19 53
Plugging commenced 9 AM April 29 19 53
Plugging completed April 29 19 53
Reason for abandonment of well or producing formation _____
Dry Hole

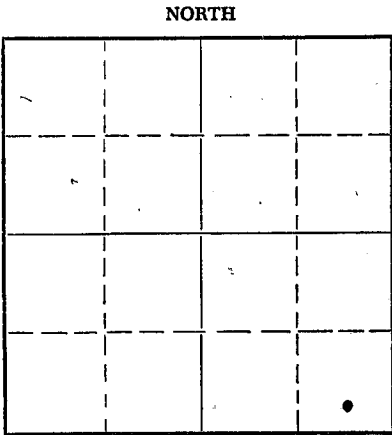

Locate well correctly on above Section Plat

If a producing well is abandoned, date of last production _____ 19 _____
Was permission obtained from the Conservation Division or its agents before plugging was commenced? _____

Name of Conservation Agent who supervised plugging of this well C. D. Stough, Great Bend, Kansas
Producing formation _____ Depth to top _____ Bottom _____ Total Depth of Well ~~354~~ 3540 Feet
Show depth and thickness of all water, oil and gas formations.

OIL, GAS OR WATER RECORDS

CASING RECORD

FORMATION	CONTENT	FROM	TO	SIZE	PUT IN	PULLED OUT

Describe in detail the manner in which the well was plugged, indicating where the mud fluid was placed and the method or methods used in introducing it into the hole. If cement or other plugs were used, state the character of same and depth placed, from _____ feet to _____ feet for each plug set.

Heavy mud, 210'. 1/3 sack of Halls. Halliburton plug, 20 sacks cement. Heavy mud to 40'. Halliburton top plug and 10 sacks cement.

Work was performed 9 AM April 29, 1953.

RECEIVED
STATE CORPORATION COMMISSION
5-6-1953
MAY - 6 1953
CONSERVATION DIVISION
Wichita, Kansas

(If additional description is necessary, use BACK of this sheet)
Name of Plugging Contractor Halliburton Oilwell Cementing
Address Duncan, Oklahoma


STATE OF KANSAS COUNTY OF RUSSELL, ss.
Mast Drlg. Inc. Contractor by Louis M. Mai (employee of owner) or (owner or operator) of the above-described well, being first duly sworn on oath, says: That I have knowledge of the facts, statements, and matters herein contained and the log of the above-described well as filed and that the same are true and correct. So help me God.

(Signature) Louis M. Mai
P. O. Box 33, Russell, Kansas
(Address)

SUBSCRIBED AND SWORN TO before me this 4 day of May, 19 53

My commission expires March 27, 1957
Dorothy Carlson Notary Public.

24-7966-S 3-53-20M
PLUGGING
FILE SEC 92T 12 11W
BOOK PAGE 98 LINE 15

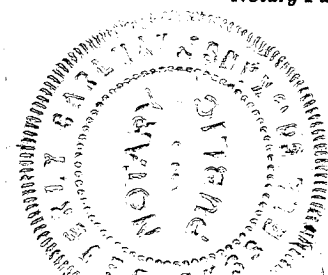

15-167-00096-00-00

OPERATOR: Borell and Miller
Wilson, Kansas

CONTRACTOR: Mast Drilling, Inc.

No. 1 Heine
SE/4 of 32-12-11
Russell County, Kansas

TOTAL DEPTH: 3540'
COMM: 4-16-53
COMPLETED: 4-29-53

Elevation: Applied for but
never received.

Cement 8 5/8" pipe at 204'
with 135 sacks cement.

FORMATION

DEPTH

Sand-iron-shale	204
Blue Shale	250
Sand	275
White Shale	310
Red Bed	442
Red Bed and Salt	800
Shalls and Iron	850
Shale and Lime Shells	1150
Shale-Lime	1345
Shale	1410
Lime	1495
Shale	1585
Lmie	1645
Shale-Lime	2577
Lime	2623
Lime and Shale Strks	2730
Lime-Shale	2879
Lime	3043
Lime and Shale	3176
Shale-Lime and Chirt	3274
Viola	3314
Lime and Shale	3351
Lime and Chirt	3376
Lime and Shale	3531
Arbuckle	3540

Bridged hole @ 210' with 1/3 sacks hulls, Halliburton plug and 20 sacks of cement. Heavy mud to 40', 1/3 sack hulls, Halliburton plug and 10 sacks of cement.

STATE OF KANSAS)
) SS
COUNTY OF RUSSELL)

I hereby certify that the above information is true and correct to the best of my knowledge.

George P. Stoepplewerth
Mast Drilling, Inc.
By: George P. Stoepplewerth
Vice President

Subscribed and Sworn to Before Me this the 19th day of May, 1953

Dorothy Carlman
Notary Public

My commission expires: 3/27/57

RECEIVED
STATE OF KANSAS
5-23-1953
MAY 23 1953
CONSERVATION DIVISION
Wichita, Kansas



PLUGGING
FILE SEC-2T-12-11-11
BOOK PAGE 98 LINE 15