


STATE OF KANSAS
STATE CORPORATION COMMISSION

Give All Information Completely
Make Required Affidavit
Mail or Deliver Report to:
Conservation Division
State Corporation Commission
800 Bitting Building
Wichita, Kansas

OR
FORMATION PLUGGING RECORD

Strike out upper line
when reporting plug-
ging off formations.

NORTH

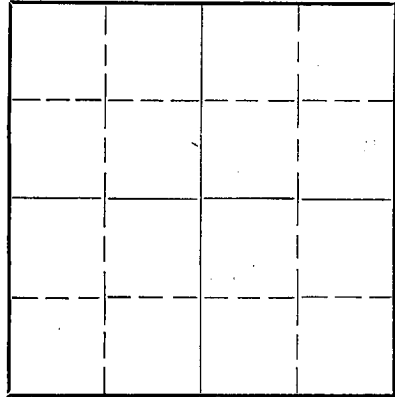

Locate well correctly on above
Section Plat

Russell County. Sec. 29 Twp. 12 Rge. 12 (E) W (W)
Location as "NE $\frac{1}{4}$ NW $\frac{1}{4}$ SW $\frac{1}{4}$ " or footage from lines C NE NE
Lease Owner Northern Ordnance Co., Inc.
Lease Name A. D. Colliver Well No. 1
Office Address Tulsa, Oklahoma
Character of Well (completed as Oil, Gas or Dry Hole) Dry hole
Date well completed June 20, 1943 19
Application for plugging filed 19
Application for plugging approved 19
Plugging commenced June 22, 1943 19
Plugging completed June 22, 1943 19
Reason for abandonment of well or producing formation Dry hole

If a producing well is abandoned, date of last production 19
Was permission obtained from the Conservation Division or its agents before plugging was com-
menced? Yes

Name of Conservation Agent who supervised plugging of this well Burt Stafford
Producing formation None Depth to top Bottom Total Depth of Well 3560 Feet
Show depth and thickness of all water, oil and gas formations.

OIL, GAS OR WATER RECORDS

CASING RECORD

Formation	Content	From	To	Size	Put In	Pulled Out
<u>None</u>				<u>10-3/4"</u>	<u>265'</u>	<u>None</u>

Describe in detail the manner in which the well was plugged, indicating where the mud fluid was placed and the method or methods used in introducing it into the hold. If cement or other plugs were used, state the character of same and depth placed, from feet to feet for each plug set.

Mud 3560 - 1300
Cement 1300 - 1250
Mud 1250 - 265
Cement 265 - 235
Mud 235 - 26
Cement 26 - 6
Mud 6 - Surface

PLUGGING
FILE NO. 29-12-12-20
BOOK PAGE 79 LINE 37

8-20-1943
AUG 20

(If additional description is necessary, use BACK of this sheet)

Correspondence regarding this well should be addressed to E. A. Rose
Address Box 786, Great Bend, Kansas

STATE OF _____, COUNTY OF _____, ss.
_____, (employee of owner) or (owner or operator) of the above-described well,
being first duly sworn on oath, says: That I have knowledge of the facts, statements, and matters herein contained and the log of the above-
described well as filed and that the same are true and correct. So help me God.

(Signature) T. L. Scott

1603 Philhower Bldg., Tulsa, Okla.
(Address)

SUBSCRIBED AND SWORN to before me this 19th day of August, 19 43

My commission expires May 4, 1947

My commission expires _____
E. Leta Walker Notary Public.

15-167-05079-00-00

NORTHERN ORDANCE INC.
 29-12S-12W
 Russell County, Kansas
 A. D. COLLIVER #1

FORMATION	FROM	TO	FORMATION	FROM	TO
Surface soil	0	42	Lime & shale	2115	2155
Sand	42	100	Shale	2155	2240
Shale & shells	100	135	Lime	2240	2251
Sand	135	143	Shale	2251	2270
Lime	143	170	Sand	2270	2280
Shale & paratese of iron brkn w/hard sand shells	170	225	Lime, shale breaks	2280	2302
Shale & shells	225	297	Broken lime	2302	2320
Shale & sand shells	297	320	Shale	2320	2338
Blue shale	320	360	Lime	2338	2344
Red bed	360	598	Shale - lime shells	2344	2412
Anhydrite	598	635	Shale & lime	2412	2484
Shale	635	740	Lime	2484	2503
Lime hard	740	800	Shale	2503	2520
Shale	800	865	Lime	2520	2548
Shale & sant	865	1040	Sandy lime	2548	2555
Salt	1040	1080	Lime	2555	2749
Shale & lime	1080	1245	Shale	2749	2770
Lime nard	1045	1305	Lime	2770	2782
Shale	1305	1315	Shale	2782	2810
Shale & lime shells	1315	1360	Lime	2810	2870
Lime	1360	1400	Lime - cherty	2870	2910
Shale & shells	1400	1450	Lime	2910	3135
Shale	1450	1550	Shale	3135	3144
Lime	1550	1594	Lime & shale	3144	3232
Lime & chert	1594	1627	Lime & chert	3232	3252
Lime	1627	1655	Shale	3252	3282
Shale	1655	1667	Shale, lime & chert	3282	3305
Lime	1667	1731	Lime & chert	3305	3329
Lime & shale	1731	1736	Lime	3329	3453
Lime	1736	1772	Sandy lime	3453	3458
Shale broken	1772	1788	Lime & shale	3458	3467
Shale	1778	1800	Lime	3467	3488
Lime	1800	1848	Lime & shale	3488	3492
Sandy lime	1848	1860	Lime, arbuckle	3492	3560
Lime & shale streaks	1860	1937			
Lime	1937	1951			
Shale	1951	1975			
Lime	1975	2020			
Shale & lime	2020	2080			
Sandy lime & shale	2080	2115			

PLUGGING
 FILE SEC 29 12 12W
 BOOK PAGE 79 LINE 37

8-20-1943