


WELL PLUGGING RECORD

Give All Information Completely
Make Required Affidavit
Mail or Deliver Report to:
Conservation Division
State Corporation Commission
800 Bittling Building
Wichita, Kansas

NORTH

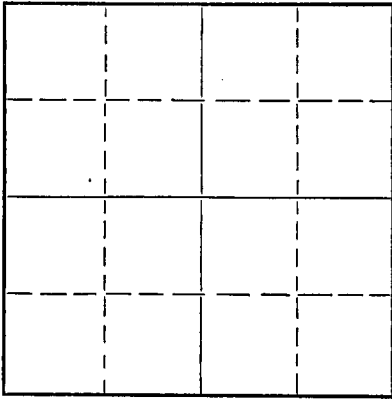

Locate well correctly on above
Section Flat

Russell County, Sec. 11 Twp. 12 Rge. 15 (E) W (W)
Location as "NE/CNW $\frac{1}{4}$ /SW $\frac{1}{4}$ " or footage from lines NE NE NE
Lease Owner Trans Era Pet., Inc.
Lease Name Foster Well No. 1
Office Address Russell, Kansas
Character of Well (completed as Oil, Gas or Dry Hole) Dry Hole
Date well completed 12/12/52 19
Application for plugging filed 12/11/52 19
Application for plugging approved 12/11/52 19
Plugging commenced 12/12/52 19
Plugging completed 12/12/52 19
Reason for abandonment of well or producing formation Dry Hole

If a producing well is abandoned, date of last production 19
Was permission obtained from the Conservation Division or its agents before plugging was commenced? Yes

Name of Conservation Agent who supervised plugging of this well C.D. Stough
Producing formation Depth to top Bottom Total Depth of Well 3295 Feet
Show depth and thickness of all water, oil and gas formations.

OIL, GAS OR WATER RECORDS

CASING RECORD

Formation	Content	From	To	Size	Put In	Pulled Out
				8 5/8"	211	None

Describe in detail the manner in which the well was plugged, indicating where the mud fluid was placed and the method or methods used in introducing it into the hole. If cement or other plugs were used, state the character of same and depth placed, from feet to feet for each plug set.

PLUGGING RECORD

Fill hole with heavy mud to 210', mix and pour 20 sacks of cement through drill pipe, $\frac{1}{2}$ sack of hulls, fill hole with mud to 35', plug $\frac{1}{2}$ sack of hulls and 10 sacks of cement, tie top plug to surface pipe.

(If additional description is necessary, use BACK of this sheet)

Name of Plugging Contractor
Address

STATE OF KANSAS, COUNTY OF RUSSELL, ss.
Herbert R. Michaelis (employee of owner) or (owner or operator) of the above-described well, being first duly sworn on oath, says: That I have knowledge of the facts, statements, and matters herein contained and the log of the above-described well as filed and that the same are true and correct. So help me God

(Signature) *H.R. Michaelis*
Russell, Kansas
(Address)

SUBSCRIBED AND SWORN to before me this 18th day of December, 19 52

My commission expires 2-8-54

23-8390-s 6-51-20M

[Signature]
Notary Public.

REC'D
STATE CORPORATION COMMISSION
12-24-1952
DEC 24 1952

PLUGGING
FILE SEC 11 T 12 R 15W
BOOK PAGE 65 LINE 45

CONSERVATION DIVISION
Wichita, Kansas

15-167-00037-00-00

Trans Era Petroleum, Inc.
Foster #1

NE NE NE 11-12-15
Russell Co., Kansas

Total Depth: 3295'
Comm. 11/29/52
Comp. 12/12/52

Casing

Cement

8 5/8" Set @ 211'

135 sacks Lone Star

Formation	Depth
Rock	35
Shale-rock	45
Shale-shells	211
Shale	260
Sand-shale	290
Shale	325
Sand-shale	390
Sand stone-iron	397
Pyrite-sand	410
Sand-pyrite-shale	500
Shale-sand	620
Red bed	825
Anhydrite	865
Shale-shells	1245
Shale-salt	1470
Shale-lime	2730
Lime	2777
Lime-shale	2885
Lime	2920
Lime-shale	2985
Lime	3227
Conglomerate	3271
Arbuckle	3295'

STATE OF KANSAS)
) ss
RUSSELL COUNTY)

I hereby certify that the above information is true and correct to the best of my knowledge.

Cora Betty

Subscribed and sworn to before me this 18th day of December, 1952.

[Signature]

Notary Public

My commission expires: 2-8-54.

PLUGGING
FILE SEC. 11-7-12-15
BOOK PAGE 65 LINE 45

RECEIVED
STATE COMMISSIONER
12-24-1952
[Stamp]