

15-167-21562-00-00


STATE OF KANSAS
STATE CORPORATION COMMISSION

WELL PLUGGING RECORD

Give All Information Completely
Make Required Affidavit
Mail or Deliver Report to
Conservation Division
State Corporation Comm.
245 North Water
Wichita, KS 67202

Russell County. Sec. 13 Twp. 12S Rge. 15 NE/W
Location as "NE/CNW1SW1" or footage from lines
C E/2 E/2 NE/4

Lease Owner Rains & Williamson Oil Co., Inc.
Lease Name Newman Trust Well No. #1
Office Address 435 Page Court, 220 W. Douglas, Wichita, Ks.
Character of Well (Completed as Oil, Gas or Dry Hole) Dry Hole

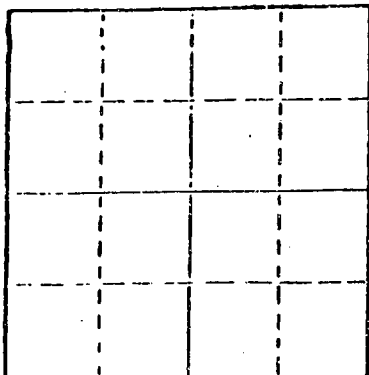

Locate well correctly on above
Section Plat

Date Well completed 12-15-80 19
Application for plugging filed 12-15-80 19
Application for plugging approved 12-15-80 19
Plugging commenced 12-15-80 19
Plugging completed 12-15-80 19

Reason for abandonment of well or producing formation
Commercial quantities of oil not found
If a producing well is abandoned, date of last production 19

Was permission obtained from the Conservation Division or
its agents before plugging was commenced? Yes

Name of Conservation Agent who supervised plugging of this well Dwayne Rankin
Producing formation _____ Depth to top _____ Bottom _____ Total Depth of Well 3126'
Show depth and thickness of all water, oil and gas formations.

OIL, GAS OR WATER RECORDS

CASING RECORD

FORMATION	CONTENT	FROM	TO	SIZE	PUT IN	PULLED OUT
				8 5/8"	710'	None

Describe in detail the manner in which the well was plugged, indicating where the mud fluid was placed and the method or methods used in introducing it into the hold. If cement or other plugs were used, state the character of same and depth placed, from _____ feet to _____ feet for each plug set.

Plug @ 700' w/40 sx.
Plug @ 300' w/25 sx.
Plug @ 40' w/10 sx.
Rat Hole . 5.sx.

(If additional description is necessary, use BACK of this sheet)

Name of Plugging Contractor Rains & Williamson Oil Co., Inc.

STATE OF Kansas COUNTY OF Sedgwick, ss.
Wilson Rains, President of Rains & Williamson Oil Co., Inc. (employee of owner) or (owner or operator) of the above-described well, being first duly sworn on oath, says: That I have knowledge of the facts, statements, and matters herein contained and the log of the above described well as filed and that the same are true and correct. So help me God.

(Signature) Wilson Rains
435 Page Court, 220 W. Douglas, Wichita, Ks. 67202
(Address)

SUBSCRIBED AND SWORN TO before me this 17 day of January, 1981



Juanita M. Green
Notary Public.

RECEIVED
STATE CORPORATION COMMISSION

1-20-1981
JAN 20 1981

CONSERVATION DIVISION
Wichita, Kansas

DRILLER'S LOG

COMPANY: Rains & Williamson Oil Co., Inc.

SEC. 13 T. 12S R. 15W

LOC. C E/2 E/2 NE/4

WELL NAME: Newman Trust #1

COUNTY: Russell

RIG NO. #4

TOTAL DEPTH 3126'

ELEVATION 1648 GL 1653 KB

COMMENCED: 12-5-80

COMPLETED: 12-15-80

CONTRACTOR: Rains & Williamson Oil Co., Inc.

CASING RECORD:

SURFACE: 8 5/8" @ 710' w/225 sx. 60/40 poz., 2% gel, 3% cc.

PRODUCTION: D&A

LOG

(Figures Indicate Bottom of Formations)

Sand & Shale	420
Shale	1390
Shale & Lime	1920
Lime & Shale	2425
Shale & Lime	2618
Lime & Shale	2711
Lime	2790
Shale	2835
Lime & Shale	2870
Shale	2890
Lime & Shale	2924
Lime	2935
Lime & Shale	2988
Lime	3065
Shale & Lime	3124
Lime	3126
<u>ROTARY TOTAL DEPTH</u>	<u>3126</u>

RECORDED & INDEXED
 JAN 20 1981
 1-20-1981
 CONSERVATION DIVISION
 Wichita, Kansas

STATE OF Kansas)
 COUNTY OF Sedgwick)


SS:

I, Wilson Rains, President of Rains & Williamson Oil Co., Inc.

upon oath state that the above and foregoing is a true and correct copy of the log of the

Newman Trust #1 well.

Wilson Rains
 Wilson Rains

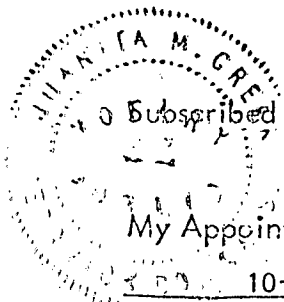

Subscribed and sworn to before me this 17 day of January, 1981.

My Appointment Expires:

10-4-83

Juanita M. Green
 Juanita M. Green