


Give All Information Completely
Make Required Affidavit
Mail or Deliver Report to:
Conservation Division
State Corporation Commission
211 No. Broadway
Wichita, Kansas

15-167-00307-00-00
WELL PLUGGING RECORD

NORTH

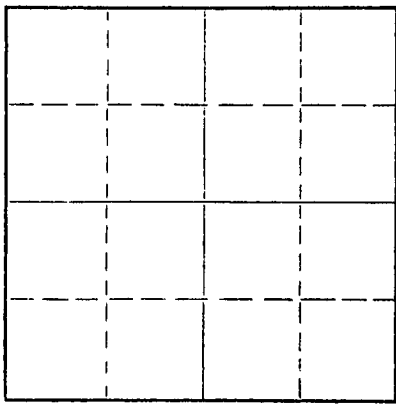

Locate well correctly on above
Section Plat

RUSSELL County. Sec. 21 Twp. 12 Rge. 15 (E) W (W)
Location as "NE/CNW/SW" or footage from lines NW/4NW/4 NE/4
Lease Owner Louis M. Mai
Lease Name Louis M. Mai - Clarke Well No. 1
Office Address Russell, Kansas.
Character of Well (completed as Oil, Gas or Dry Hole) _____
Date well completed _____ 19____
Application for plugging filed _____ 19____
Application for plugging approved _____ 19____
Plugging commenced Nov 11 19 57
Plugging completed Nov 15 19 57
Reason for abandonment of well or producing formation _____

If a producing well is abandoned, date of last production _____ 19____
Was permission obtained from the Conservation Division or its agents before plugging was commenced? yes.

Name of Conservation Agent who supervised plugging of this well Donald Truan
Producing formation _____ Depth to top _____ Bottom _____ Total Depth of Well 3175 Feet
Show depth and thickness of all water, oil and gas formations.

OIL, GAS OR WATER RECORDS

CASING RECORD

FORMATION	CONTENT	FROM	TO	SIZE	PUT IN	PULLED OUT

Describe in detail the manner in which the well was plugged, indicating where the mud fluid was placed and the method or methods used in introducing it into the hole. If cement or other plugs were used, state the character of same and depth placed, from 3175 feet to surface, feet for each plug set.

Bottom of well had been filled with three foot plastic plug from 3175 to 3172; Hole filled with sand from 3172 ft. to 3160 ft; five sacks of cement dumped in hole with dump bailer; pipe shot off at 2765 and pipe pulled from hole. Hole then filled with mud to 250 feet; rock bridge installed at 250 feet and 25 sacks of cement poured in hole; Hole filled with mud to 35 feet. A second rock bridge installed and ten sacks of cement poured in hole to make cement cap to bottom of cellar

RECEIVED
STATE CORPORATION COMMISSION
11-25-1957
NOV 25 1957
CONSERVATION DIVISION
Wichita, Kansas

(If additional description is necessary, use BACK of this sheet)
Name of Plugging Contractor Barnes and Sons Pipe Pulling Co.,
Address Russell, Kansas.

STATE OF Kansas, COUNTY OF Russell, ss.
Louis M. Mai (employee of owner) or (owner or operator) of the above-described well, being first duly sworn on oath, says: That I have knowledge of the facts, statements, and matters herein contained and the log of the above-described well as filed and that the same are true and correct. So help me God.

(Signature) Louis M Mai
Russell (Address)

SUBSCRIBED AND SWORN TO before me this 22nd day of November, 19 57
Betty Jean Sylvest Notary Public.

My commission expires 8-9-58

PLUGGING
FILE SEC 21 T 12 R 15 W
BOOK PAGE 55 LINE 4

15-167-00307-00-00

WELL LOG

OPERATOR: Vernon Most et al
Maywood, Nebraska

CONTRACTOR: Mast Drilling, Inc.
Russell, Kansas

LEASE: Clarke #1
NW NW NE
Sec. 21-12-15W
Russell County, Kansas

COMMENCED: 9-21-57

COMPLETED: 9-30-57

FORMATION	DEPTH
Surface Clay & Shale	203
Sand & Pyrite	320
Shale	540
Red Bed	787
Anhydrite	822
Shale	1100
Shale & Lime	1910
Shale	2600
Lime	2778
Shale & Lime	2835
Lime	3092
Lime & Chert	3128
Lime & Arbuckle	3174
TOTAL DEPTH	3174

I hereby certify that the above is true and correct to the best of my knowledge.

Richard L. Mai

STATE OF KANSAS)
)ss
COUNTY OF RUSSELL)

Subscribed and sworn to before me this 18th day of October, 1957.

Betty Jean Galyardt
Notary Public

My Commission expires 8-9-58

10-21-1957
OCT 21

FLUORINE
SEC 21 T. 12 R. 15W
55 4