


WELL PLUGGING RECORD

Give All Information Completely
Make Required Affidavit
Mail or Deliver Report to:
Conservation Division
State Corporation Commission
211 No. Broadway
Wichita, Kansas

Russell County. Sec. 21 Twp. 12 Rge. 15 (E) (W)
Location as "NE/CNW%SW%" or footage from lines NW SW SW
Lease Owner Fred J. Haynes
Lease Name Schmeidler Well No. 1
Office Address Bldg. & Loan Bldg. Russell, Kansas
Character of Well (completed as Oil, Gas or Dry Hole) Dry Hole
Date well completed December 18 19 56
Application for plugging filed December 18 19 56
Application for plugging approved December 18 19 56
Plugging commenced December 18 19 56
Plugging completed December 18 19 56
Reason for abandonment of well or producing formation D & A

NORTH

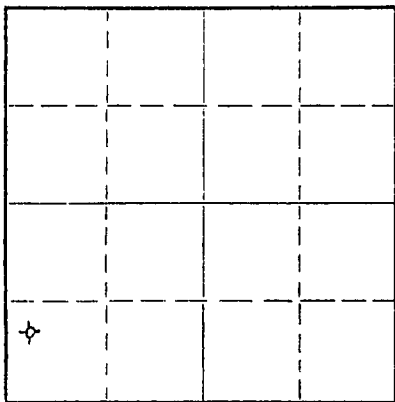

Locate well correctly on above
Section Plat

If a producing well is abandoned, date of last production _____ 19____
Was permission obtained from the Conservation Division or its agents before plugging was commenced? Yes

Name of Conservation Agent who supervised plugging of this well Milton Galyardt
Producing formation _____ Depth to top _____ Bottom _____ Total Depth of Well 3350 Feet
Show depth and thickness of all water, oil and gas formations.

OIL, GAS OR WATER RECORDS

CASING RECORD

FORMATION	CONTENT	FROM	TO	SIZE	PUT IN	PULLED OUT
				8 5/8"	200'	None

Describe in detail the manner in which the well was plugged, indicating where the mud fluid was placed and the method or methods used in introducing it into the hole. If cement or other plugs were used, state the character of same and depth placed, from 195' feet to _____ feet for each plug set.
Plugged hole at 195' with 1/2 sack hulls and 20 sacks cement. Filled hole with mud, set plug at 40' with 1/2 sack hulls and 10 sacks cement.

RECEIVED
STATE CORPORATION COMMISSION
12-27-1956
WICHITA, KANSAS

(If additional description is necessary, use BACK of this sheet)
Name of Plugging Contractor Haynes Drilling Company
Address Russell, Kansas

STATE OF Kansas, COUNTY OF Russell, ss.
Darroll E. Haynes (employee of owner) or (owner or operator) of the above-described well, being first duly sworn on oath, says: That I have knowledge of the facts, statements, and matters herein contained and the log of the above-described well as filed and that the same are true and correct. So help me God.
(Signature) Darroll E. Haynes
Bldg. & Loan Bldg. Russell, Kansas
(Address)

SUBSCRIBED AND SWORN to before me this 26th day of December, 1956
Robert L. Schulte
Notary Public.

My commission expires January 17, 1957.

PLUGGING
R 21 T 12 R 15 W
BOOK 127 PAGE 5

15-167-00129-00-00

DRILLERS LOG

Schmeidler # 1
NW SW SW 21-12-15W
Russell County, Kansas

COMMENCED: 12/5/56
COMPLETED: 12/18/56

CONTRACTOR: HAYNES DRILLING COMPANY
Russell, Kansas

FORMATION

IP: D & A

Rock, Sand, Shale	200
Shale	435
Iron & Sand	465
Sand & Shale	600
Red Bed & Shale	927
Anhydrite	928-971
Red Bed & Shale	1350
Salt & Shale	1550
Shale & Lime	1640
Lime	1867
Lime & Shale	1930
Lime	2005
Lime & Shale	2500
Shale	2690
Lime	2787
Lime & Shale	2904
Lime	3005
Lime	3285
Conglomerate	3300
Lime	3350
TD	3350

CASING: 200' 8 5/8"

I hereby certify that the above is true and correct to the best of my knowledge.

Danell E. Haynes

DRILLING	
NO. 21 T. 12. R 15W	
BLK. 127	127 LINE 5

RECEIVED
STATE OF KANSAS
12-27-1956