


WELL PLUGGING RECORD

Give All Information Completely
Make Required Affidavit
Mail or Deliver Report to:
Conservation Division
State Corporation Commission
211 No. Broadway
Wichita, Kansas

NORTH

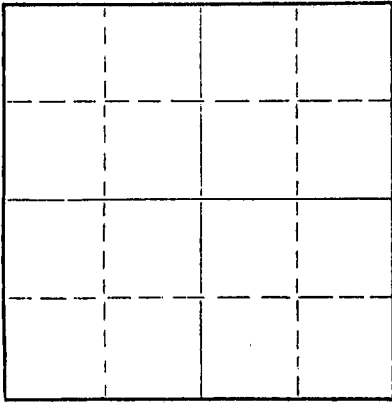

Locate well correctly on above
Section Plat

Russell

County. Sec. 24 Twp. 12 Rge. 15W () (W)

Location as "NE/CNW%SW%" or footage from lines NW NW SW

Lease Owner Terrel Producers

Lease Name Jennrich Well No. 1

Office Address Russell, Kansas

Character of Well (completed as Oil, Gas or Dry Hole) DRY HOLE

Date well completed _____ 19__

Application for plugging filed _____ 19__

Application for plugging approved _____ 19__

Plugging commenced _____ 19__

Plugging completed September 4, 19 59

Reason for abandonment of well or producing formation _____

If a producing well is abandoned, date of last production _____ 19__

Was permission obtained from the Conservation Division or its agents before plugging was commenced? YES

Name of Conservation Agent who supervised plugging of this well Donald Truan

Producing formation _____ Depth to top _____ Bottom _____ Total Depth of Well 3300' Feet

Show depth and thickness of all water, oil and gas formations.

OIL, GAS OR WATER RECORDS

CASING RECORD

FORMATION	CONTENT	FROM	TO	SIZE	PUT IN	PULLED OUT

Describe in detail the manner in which the well was plugged, indicating where the mud fluid was placed and the method or methods used in introducing it into the hole. If cement or other plugs were used, state the character of same and depth placed, from _____ feet to _____ feet for each plug set.

Filled hole with heavy mud to 280', 1/4 sacks hulls, plug, & 100 sacks cement with Sun Cementing Co. pump truck, cementing from 300' to base of cellar.

RECEIVED
STATE CORPORATION COMMISSION

SEP 9 1963
9-9-1963

CONSERVATION DIVISION
Wichita, Kansas

(If additional description is necessary, use BACK of this sheet)

Name of Plugging Contractor Jackson Drilling Co.

Address Box 194 Great Bend, Kansas

STATE OF Kansas, COUNTY OF Russell, ss.
Joe R. Branum (employee of owner) or (owner or operator) of the above-described well, being first duly sworn on oath, says: That I have knowledge of the facts, statements, and matters herein contained and the log of the above-described well as filed and that the same are true and correct. So help me God.

(Signature) Joe R. Branum

(Address) _____

SUBSCRIBED AND SWORN TO before me this 10th day of September, 1963

My commission expires November 13, 1963

Mary Anna Branum
Notary Public.

15-167-00092-00-00

WELL LOG
Jennrich # 1
NW NW SW 24-12-15
Russell County, Kansas

0 - 70	Surface soil	<u>Elevation</u>	1894' DF
70 - 160	Sand, shale and shells		
160 - 240	Shale		
240 - 390	Shale and sand		
390 - 420	Iron sand	<u>Formation Tops:</u>	
420 - 455	Shale and sand		
455 - 870	Red bed and shale	Anhydrite	870
870 - 910	Anhydrite	Heebner	2930
910 - 1545	Shale	Lansing	2981
1545 - 1685	Lime and shale	Arbuckle	3267
1685 - 1810	Lime		
1810 - 2500	Lime and shale		
2500 - 2645	Shale		
2645 - 2775	Lime and shale		
2775 - 3260	Lime		
3260 - 3275	Lime and shale		
3275 - 3300	Lime		
3300	T. D.		

STATE OF KANSAS
2-21-1963
FEB 21 1963

STATE OF KANSAS

COUNTY OF BARTON ss

C. L. Miles, partner of A. L. Jackson Drilling Company, being first duly sworn on oath says: That I have knowledge of the facts, statements, and matters herein contained and the log of the above described well as filed and that the same are true and correct.

C. L. Miles

C. L. Miles

Subscribed and sworn before me this 8th day of September, 1959.

Notary Public

Notary Public Barton County

My Commission Expires: May 9, 1963.

FEB 21 1963