

STATE OF KANSAS
STATE CORPORATION COMMISSION


Give All Information Completely
Make Required Affidavit
Mail or Deliver Report to:
Conservation Division
State Corporation Commission
211 No. Broadway
Wichita, Kansas

15-167-00113-00-00

WELL PLUGGING RECORD

Russell County, Sec. 25 Twp. 12 Rge. (W) 15 (W)

NORTH

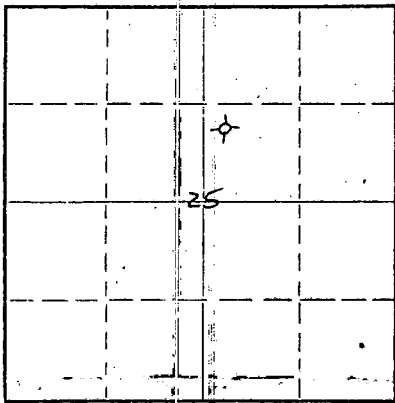

Locate well correctly on above Section Plat

Location as "NE/CNW/SW" or footage from lines NW SW NE
Lease Owner Wood Petroleum Company
Lease Name Krug Well No. 1
Office Address Box 619, Great Bend, Kansas
Character of Well (completed as Oil, Gas or Dry Hole) Dry Hole
Date well completed 10-29 1959
Application for plugging filed 11-3 1959
Application for plugging approved 19
Plugging commenced 10:30 am 10-29- 1959
Plugging completed 2:30 pm 10-29 1959
Reason for abandonment of well or producing formation Dry Hole

If a producing well is abandoned, date of last production 19
Was permission obtained from the Conservation Division or its agents before plugging was commenced? Yes

Name of Conservation Agent who supervised plugging of this well Mr. Don Trvan
Producing formation _____ Depth to top _____ Bottom _____ Total Depth of Well 3294 Feet
Show depth and thickness of all water, oil and gas formations.

OIL, GAS OR WATER RECORDS

CASING RECORD

FORMATION	CONTENT	FROM	TO	SIZE	PUT IN	PULLED OUT
				8 5/8"	235'	None

Describe in detail the manner in which the well was plugged, indicating where the mud fluid was placed and the method or methods used in introducing it into the hole. If cement or other plugs were used, state the character of same and depth placed, from _____ feet to _____ feet for each plug set.

Bottom plug set at 225", 1/4 sack of hulls below plug; 25 sacks cement, mud up to 40", plug, 10 sacks cement and 1/2 sack hulls on top of plug, 2 sacks cement in rathole.

RECEIVED
STATE CORPORATION COMMISSION
NOV 5 1959
CONSERVATION DIVISION
Wichita, Kansas

(If additional description is necessary, use BACK of this sheet)
Name of Plugging Contractor Triangle Drilling, Inc.
Address Box 287, Russell, Kansas

STATE OF Kansas, COUNTY OF Barton, ss.
Donald D. Vaughan (employee of owner) or (owner or operator) of the above-described well, being first duly sworn on oath, says: That I have knowledge of the facts, statements, and matters herein contained and the log of the above-described well as filed and that the same are true and correct. So help me God.

(Signature) Donald D. Vaughan

Box 619, Great Bend, Kansas

(Address)

SUBSCRIBED AND SWORN TO before me this 2nd day of November, 19 59

Donna Lea Foelgner

Donna Lea Foelgner

Notary Public.

My commission expires May 11, 1963.



15-167-00113-00-00

WELL LOG

COMPANY
CONTRACTOR
FARM
LOCATION

Wood Petroleum Company
Triangle Drilling, Inc.
#1 Krug
NW SW NE of Section 25-12-15W
Russell County, Kansas

ELEVATION
SURFACE PIPE
PRODUCTION
COMMENCED
COMPLETED

1788 KB
8 5/8" cemented @ 235' w/160 sacks Sunset cement
D & A
October 20, 1959
October 29, 1959

<u>FORMATION</u>	<u>DEPTH</u>
Surface clay and post rock	10
Post rock and shale	40
Shale	160
Clay and shale	235
Shale and sand streaks	524
Red bed	848
Anhydrite	882
Shale and shells	1500
Limestone and shale	1725
Broken limestone	1970
Limestone and shale	2662
Limestone	2954
Shale	2974
Limestone	3203
Limestone and shale	3265
Chert Conglomerate	3294
<u>Formation Tops</u>	
Anhydrite	848 (+ 940)
Heebner	2918 (-1130)
Toronto	2938 (-1150)
Lansing	2974 (-1186)
Base Kansas City	3203 (-1415)
Chert Conglomerate	3265 (-1477)
RTD	3294 (-1506)

RECEIVED
STATE CORPORATION COMMISSION
NOV 5 - 1959
CONSERVATION DIVISION
Wichita, Kansas

A F F I D A V I T

STATE OF KANSAS, COUNTY OF BARTON, SS.

I, Donald D. Vaughan, of the TRIANGLE DRILLING, INC., being first duly sworn on oath, state; That I have knowledge of the facts, statements and matters herein contained and that the same are true and correct.

Donald D. Vaughan
Donald D. Vaughan

Subscribed and sworn to before me this 30th day of October, 1959.

Donna Lea Foelgner
Donna Lea Foelgner, Notary Public

My Commission expires: May 11, 1963.

