

STATE OF KANSAS
STATE CORPORATION COMMISSION

Give All Information Completely.
Make Required Affidavit
Mail or Deliver Report to:
Conservation Division
State Corporation Commission
800 Bitting Building
Wichita, Kansas

15-167-00049-00-00
WELL PLUGGING RECORD

Russell County. Sec. 32 Twp. 12 Rge. (E) 15(W)

Location as "NE/CNW4SW4" or footage from lines SH, NW, NE

Lease Owner San Kessler & Alex Schmidt

Lease Name McKune Well No. #1

Office Address Russell, Kansas

Character of Well (completed as Oil, Gas or Dry Hole) Dry Hole

Date well completed October 7 19 53

Application for plugging filed October 8 19 53

Application for plugging approved October 8 19 53


Plugging commenced October 8 19 53

Plugging completed 19

Reason for abandonment of well or producing formation _____

If a producing well is abandoned, date of last production 19

Was permission obtained from the Conservation Division or its agents before plugging was commenced? Yes

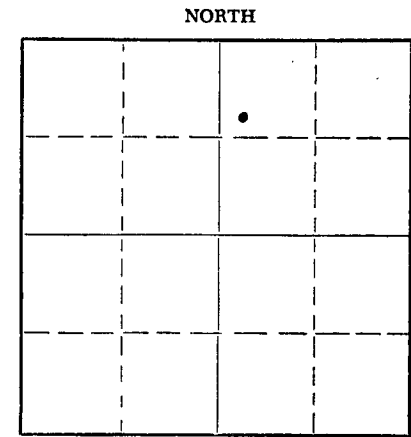

Locate well correctly on above Section Plat

Name of Conservation Agent who supervised plugging of this well Eden Petty

Producing formation _____ Depth to top _____ Bottom _____ Total Depth of Well 3410 Feet

Show depth and thickness of all water, oil and gas formations.

OIL, GAS OR WATER RECORDS

CASING RECORD

FORMATION	CONTENT	FROM	TO	SIZE	PUT IN	PULLED OUT
Sand	Water	465	478	15 1/2	480	480
Anhydrite		950	960	12 1/2	21	21
				10"	29	29
				8"	80	80
				7"	97	97
				5"	114	114

Describe in detail the manner in which the well was plugged, indicating where the mud fluid was placed and the method or methods used in introducing it into the hole. If cement or other plugs were used, state the character of same and depth placed, from _____ feet to _____ feet for each plug set.

Pumped in heavy mud from 3400 to the surface, then pulled 7" casing.

Pumped in heavy mud and pulled 8" casing.

Pumped in heavy mud and pulled 10" casing.

Pumped in heavy mud and pulled 13" casing.

Set rock bridge 300' and cemented with 25 sacks cement on rock bridge.

Pumped heavy mud to surface.

Set rock bridge 25', filled to surface with rock and cement.

10-12-1953

(If additional description is necessary, use BACK of this sheet)

Name of Plugging Contractor Julian Oil & Royalty Company

Address Russell, Kansas

STATE OF Kansas, COUNTY OF Russell, ss. Ted Rutherford (employee of owner) or (owner or operator) of the above-described

well, being first duly sworn on oath, says: That I have knowledge of the facts, statements, and matters herein contained and the log of the above-described well as filed and that the same are true and correct. So help me God.


(Signature) G E Wentworth

Russell, Kansas
(Address)

SUBSCRIBED AND SWORN to before me this 9th day of October, 19 53

My commission expires April 23, 1956. Bonnie Berryhill Notary Public.

24-2675-5 2-52-20M

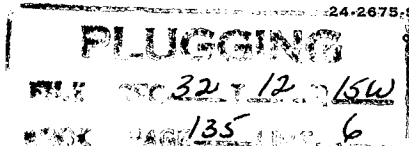

15-167-00049-00-00

Form 1002A


OPERATOR Sam Kessler & Alex Schmidt

FORMATION RECORD

Give detailed description and thickness of all formations drilled through, contents of sand, whether dry, water, oil or gas.

ADDRESS Russell, Kansas

WELL NO. #1 COUNTY Russell TWP 12 SEC 32 RGE 15

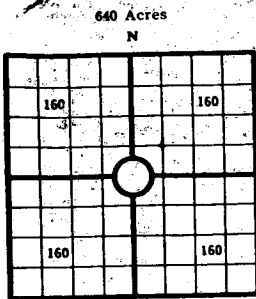

COUNTY Russell SEC 32 TWP 12 RGE 15
COMPANY OPERATING Julian Oil & Royalty Co.
OFFICE ADDRESS Russell, Kansas
FARM NAME McKune WELL NO. 41
DRILLING STARTED 8-14 1953 DRILLING FINISHED 10-7 1953
DATE OF FIRST PRODUCTION COMPLETED
WELL LOCATED SW 1/4 NW 1/4 NE 1/4 North of South
Line and ft. East of West Line of Quarter Section
Elevation (Relative to sea level) DERRICK FLOOR 1876 GROUND 1873
CHARACTER OF WELL (Oil, gas or dryhole) Dry

OIL OR GAS SANDS OR ZONES

Name	From	To	Name	From	To
1			4		
2			5		
3			6		

Perforating Record If Any

Shot Record

Formation	From	To	No. of Shots	Formation	From	To	Size of Shot

CASING RECORD

Amount Set						Amount Pulled		Packer Record			
Size	Wt.	Thds.	Make	Ft.	In.	Ft.	In.	Size	Length	Depth Set	Make

Liner Record: Amount Kind Top Bottom

CEMENTING AND MUDDING

Size	Amount Set		Sacks Cement	Chemical		Method of Cementing	Amount	Mudding Method	Results (See Note)
	Ft.	In.		Gal.	Make				

Note: What method was used to protect sands if outer strings were pulled?

NOTE: Were bottom hole plugs used? If so, state kind, depth set and results obtained

TOOLS USED

Rotary Tools were used from feet to feet Cable tools were used from feet to feet, and from feet to feet, and from feet to feet, and from feet to feet

Type Rig

INITIAL PRODUCTION TEST

Describe initial test: whether by flow through tubing or casing or by pumping

Amount of Oil Production bbls: Size of choke, if any Length of test Water

Production bbls Gravity of oil Type of Pump if pump is used, describe

Formation	Top	Bottom	Formation	Top	Bottom
Shale & Shells	2420	2475	Shale	3295	3301
Red Rock	2475	2480	Lime	3301	3304
Shale	2480	2535	Shale Brown	3304	3307
Lime	2535	2560	Lime	3307	3311
Shale	2560	2590	Shale	3311	3317
Lime	2590	2595	Lime	3317	3330
Shale	2595	2600	Lime Cherty	3330	3335
Lime	2600	2610	Lime	3335	3347
Shale	2610	2620	Red Rock	3347	3353
Lime	2620	2650	Lime	3353	3360
Shale	2650	2660	Cong.	3360	3389
Lime	2660	2685	Lime Arb.	3389	3395
Shale & Shells	2685	2725	Lime	3395	3407
Shale	2725	2735	Sand Water	3407	3410
Lime	2735	2750			
Shale	2750	2755			
Lime	2755	2868	Total Depth	3410	
Shale	2868	2873			
Lime	2873	2950			
Lime Soft	2950	2970			
Lime Hard	2970	2985			
Lime	2985	3010			
Shale Black	3010	3017			
Lime	3017	3039			
Red Rock	3039	3045			
Shale Blue	3045	3050			
Lime	3050	3068			
Shale	3068	3074			
Lime	3074	3118			
Shale	3118	3120			
Lime	3120	3178			
Shale	3178	3180			
Lime	3180	3220			
Shale	3220	3225			
Lime	3225	3275			
Shale	3275	3280			
Lime	3280	3295			

PLUGGING
FILL SEC 32 T 12 R 15 W
BOOK PAGE 135 LINE 6

I, the undersigned, being first duly sworn upon oath, state that this well record is true, correct and complete according to the records of this office and to the best of my knowledge and belief.

J. C. Wauters
Name and title of representative of company

Subscribed and sworn to before me this 10th day of October 1953
My Commission expires April 23, 1956
Bernie Berryhill
Notary Public