

STATE OF KANSAS
STATE CORPORATION COMMISSION

15-167-00098-00-00
WELL PLUGGING RECORD


Give All Information Completely
Make Required Affidavit
Mail or Deliver Report to:
Conservation Division
State Corporation Commission
211 No. Broadway
Wichita, Kansas

Russell

County. Sec. 33 Twp. 12 Rge. 15 (W)

Location as "NE/CNW%SW%" or footage from lines NW SW SW
Lease Owner A. F. Schmidt
Lease Name Mermis B Well No. 1
Office Address Box 662 Russell, Kansas
Character of Well (completed as Oil, Gas or Dry Hole) Dry hole
Date well completed November 13 1959
Application for plugging filed November 17 1959
Application for plugging approved _____ 19____
Plugging commenced 1:45 am November 13 1959
Plugging completed 8:30 am " " 1959
Reason for abandonment of well or producing formation dry hole

NORTH

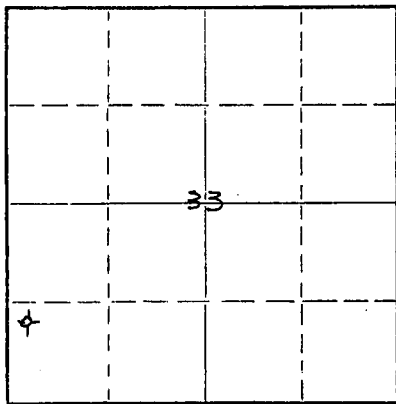

Locate well correctly on above
Section Plat

If a producing well is abandoned, date of last production _____ 19____
Was permission obtained from the Conservation Division or its agents before plugging was commenced? yes

Name of Conservation Agent who supervised plugging of this well Mr. Don Truan
Producing formation _____ Depth to top _____ Bottom _____ Total Depth of Well 3400 Feet
Show depth and thickness of all water, oil and gas formations.

OIL, GAS OR WATER RECORDS

CASING RECORD

FORMATION	CONTENT	FROM	TO	SIZE	PUT IN	PULLED OUT
				8 5/8	217'	none

Describe in detail the manner in which the well was plugged, indicating where the mud fluid was placed and the method or methods used in introducing it into the hole. If cement or other plugs were used, state the character of same and depth placed, from _____ feet to _____ feet for each plug set.

Bottom plug at 200', 1/4 sack of hulls and 25 sacks of cement, mud up to 35', plug, 1/2 sack of hulls and 10 sacks of cement, 2 sacks of cement in rathole.

RECEIVED
STATE CORPORATION COMMISSION
11-20-1959
NOV 20 1959
CONSERVATION DIVISION
WICHITA


(If additional description is necessary, use BACK of this sheet)
Name of Plugging Contractor Triangle Drilling, Inc.
Address Box 287 Russell, Kansas

STATE OF Kansas COUNTY OF Barton, ss.
Donald D. Vaughan (employee of owner) or (owner or operator) of the above-described well, being first duly sworn on oath, says: That I have knowledge of the facts, statements, and matters herein contained and the log of the above-described well as filed and that the same are true and correct. So help me God.

(Signature) Donald D. Vaughan
Box 619 Great Bend, Kansas
(Address)

SUBSCRIBED AND SWORN to before me this 18th day of November, 1959

My commission expires May 11, 1963
Donna Lea Foelgner
Donna Lea Foelgner Notary Public.

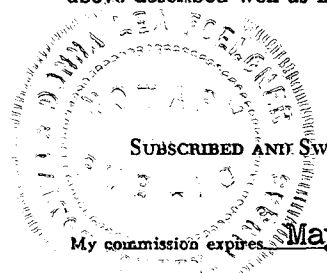

COMPANY A. F. Schmidt
 CONTRACTOR Triangle Drilling, Inc.
 FARM #1 Mermis 'B'
 LOCATION NW SW SW of Section 33-12-15W
 Russell County, Kansas
 ELEVATION 1856 KB
 SURFACE PIPE 8 5/8" cemented @ 217' w/145 sacks HAS cement.
 PRODUCTION D & A
 COMMENCED November 1, 1959
 COMPLETED November 13, 1959

FORMATION	DEPTH
Surface clay and post rock	40
Shale and shells	217
Shale, clay and sand streaks	583
Red bed	941
Anhydrite	972
Shale and shells	1665
Limestone and shale	1910
Broken limestone	2050
Limestone and shale	2755
Limestone	3017
Shale	3033
Limestone	3302
Conglomerate	3304
Dolomite	3400

FORMATION TOPS

Anhydrite	941 (/ 915)
Heebner	2983 (-1127)
Toronto	3003 (-1147)
Lansing	3033 (-1177)
Conglomerate	3302 (-1446)
Arbuckle	3304 (-1448)
RTD	3400 (-1544)

RECEIVED
 STATE CORPORATE COMMISSION
 11-20-1959
 NOV 20 1959
 CONSERVATION DIVISION
 Wichita, Kansas


STATE OF KANSAS, COUNTY OF BARTON, SS.

I, Donald D. Vaughan, of the TRIANGLE DRILLING, INC., being first duly sworn on oath, state; That I have knowledge of the facts, statements and matters herein contained and that the same are true and correct.

Donald D. Vaughan
 Donald D. Vaughan

Subscribed and sworn to before me this 14th day of November, 1959.

Donna Lea Fealner
 Donna Lea Fealner
 Notary Public

My commission expires: May 11, 1963.

